ARUN DISTRICT COUNCIL AB/76/17/CLE

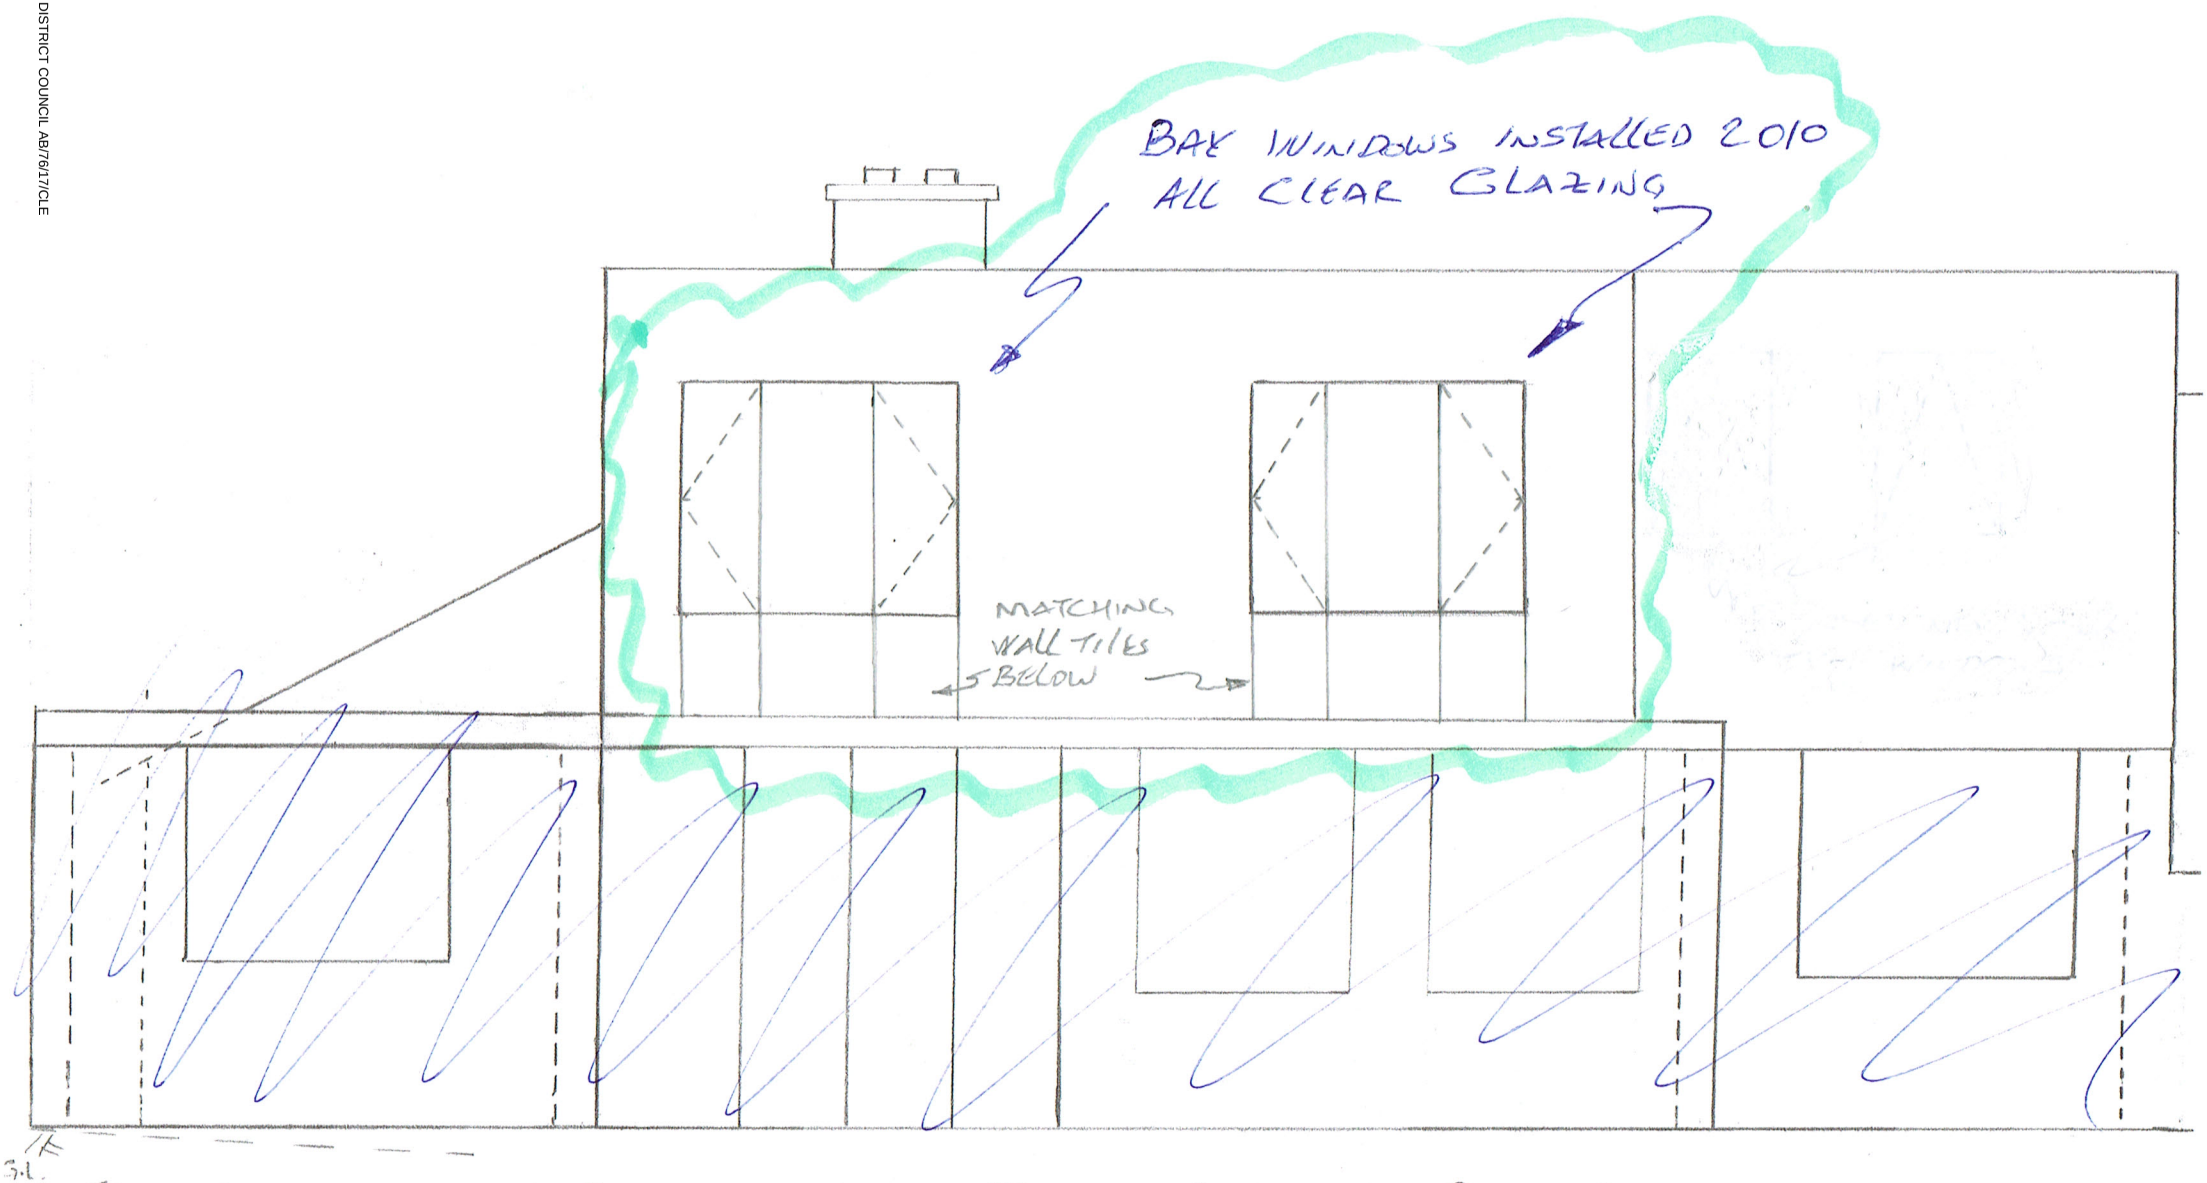

JILL HAWTHORNE & PETER CONNOLLY
3 STEWARDS RISE
ARUNDEL

REAR ELEVATION

AS INSTALLED 2010

SCALE 1:50

G.L.

20/6/17