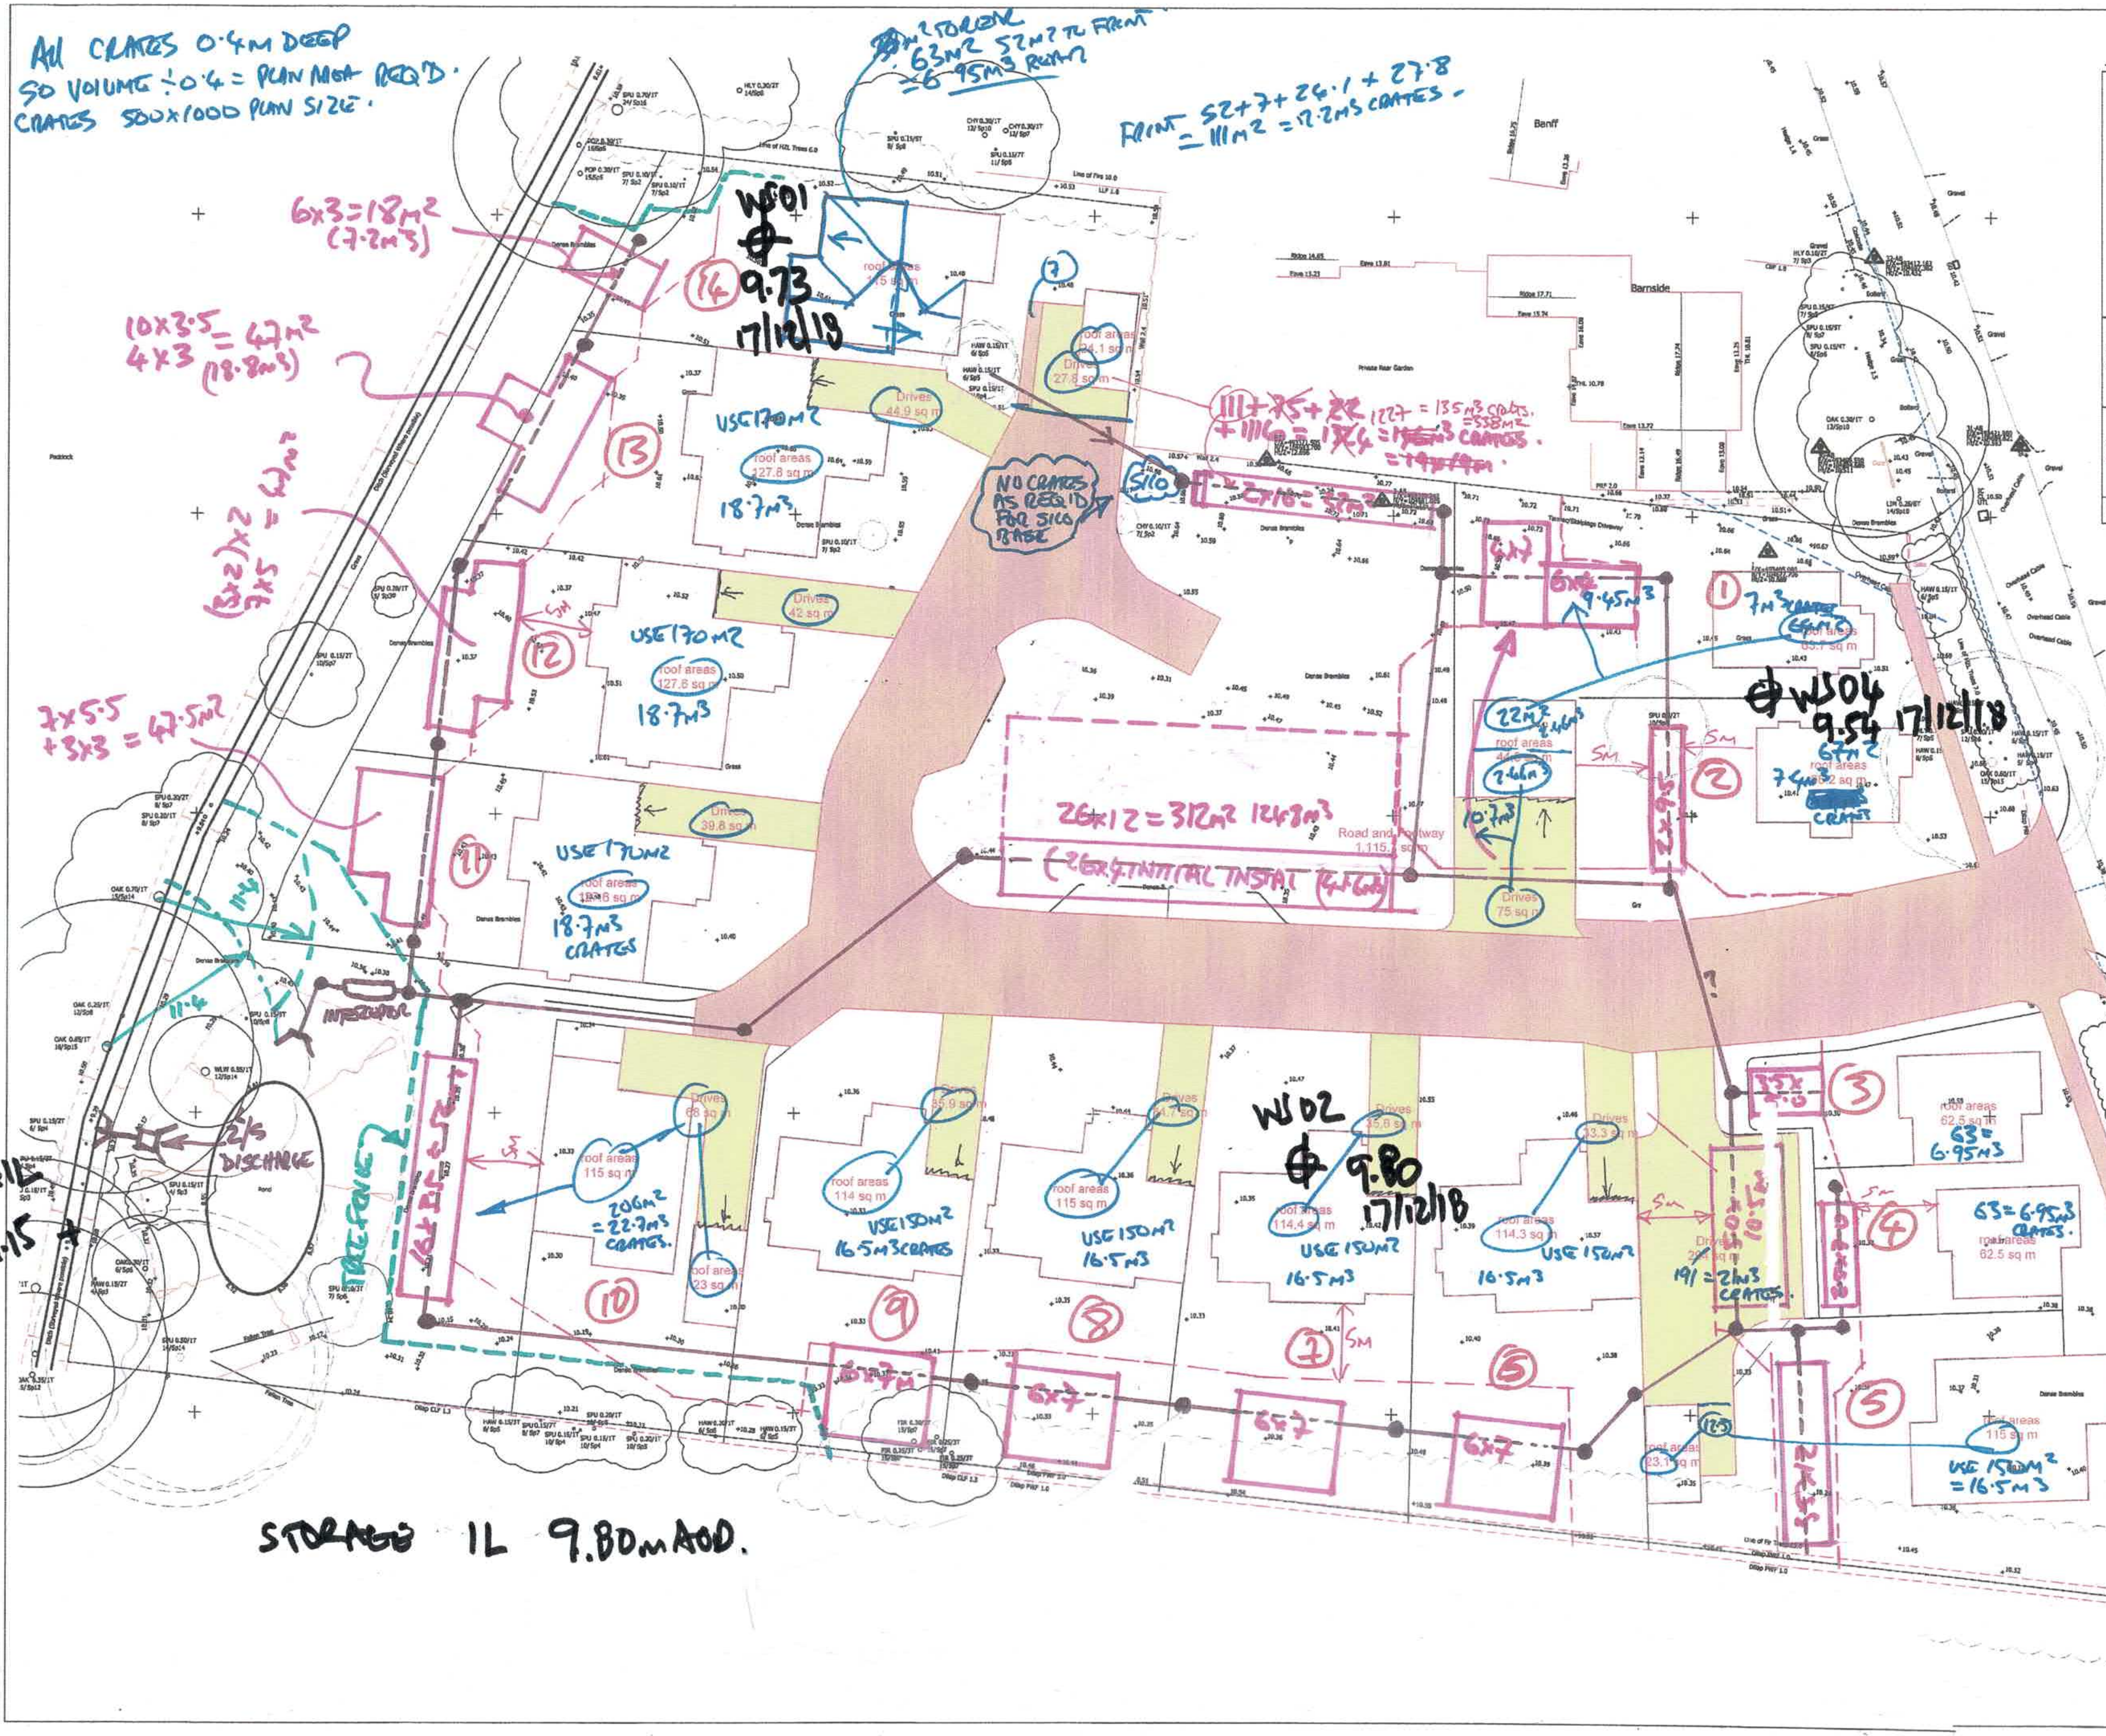

This drawing is the copyright of MAPLEDEAN PROJECTS LIMITED no copies in whole or part thereof may be taken without prior consent.

Mapledean
DOING THE RIGHT THINGS

MAPLEDEAN PROJECTS LIMITED
HOLLYTHORNS HOUSE
NEW ROAD, SWANMORE
HAMPSHIRE, SO32 2NW
TEL: 01489 896668 FAX: 01489 896636

Job Title.
HOOK LANE, ALDINGBOURNE, CHICHESTER, PO20 3TE for METIS HOMES Ltd

Description.
SITE WORKS BASE PLAN
S.W. MARK UP AS ANDY TRAVES . 19/6/19

Scale: 1-200 Date: MAY '19 Drawing No: HLA-201