


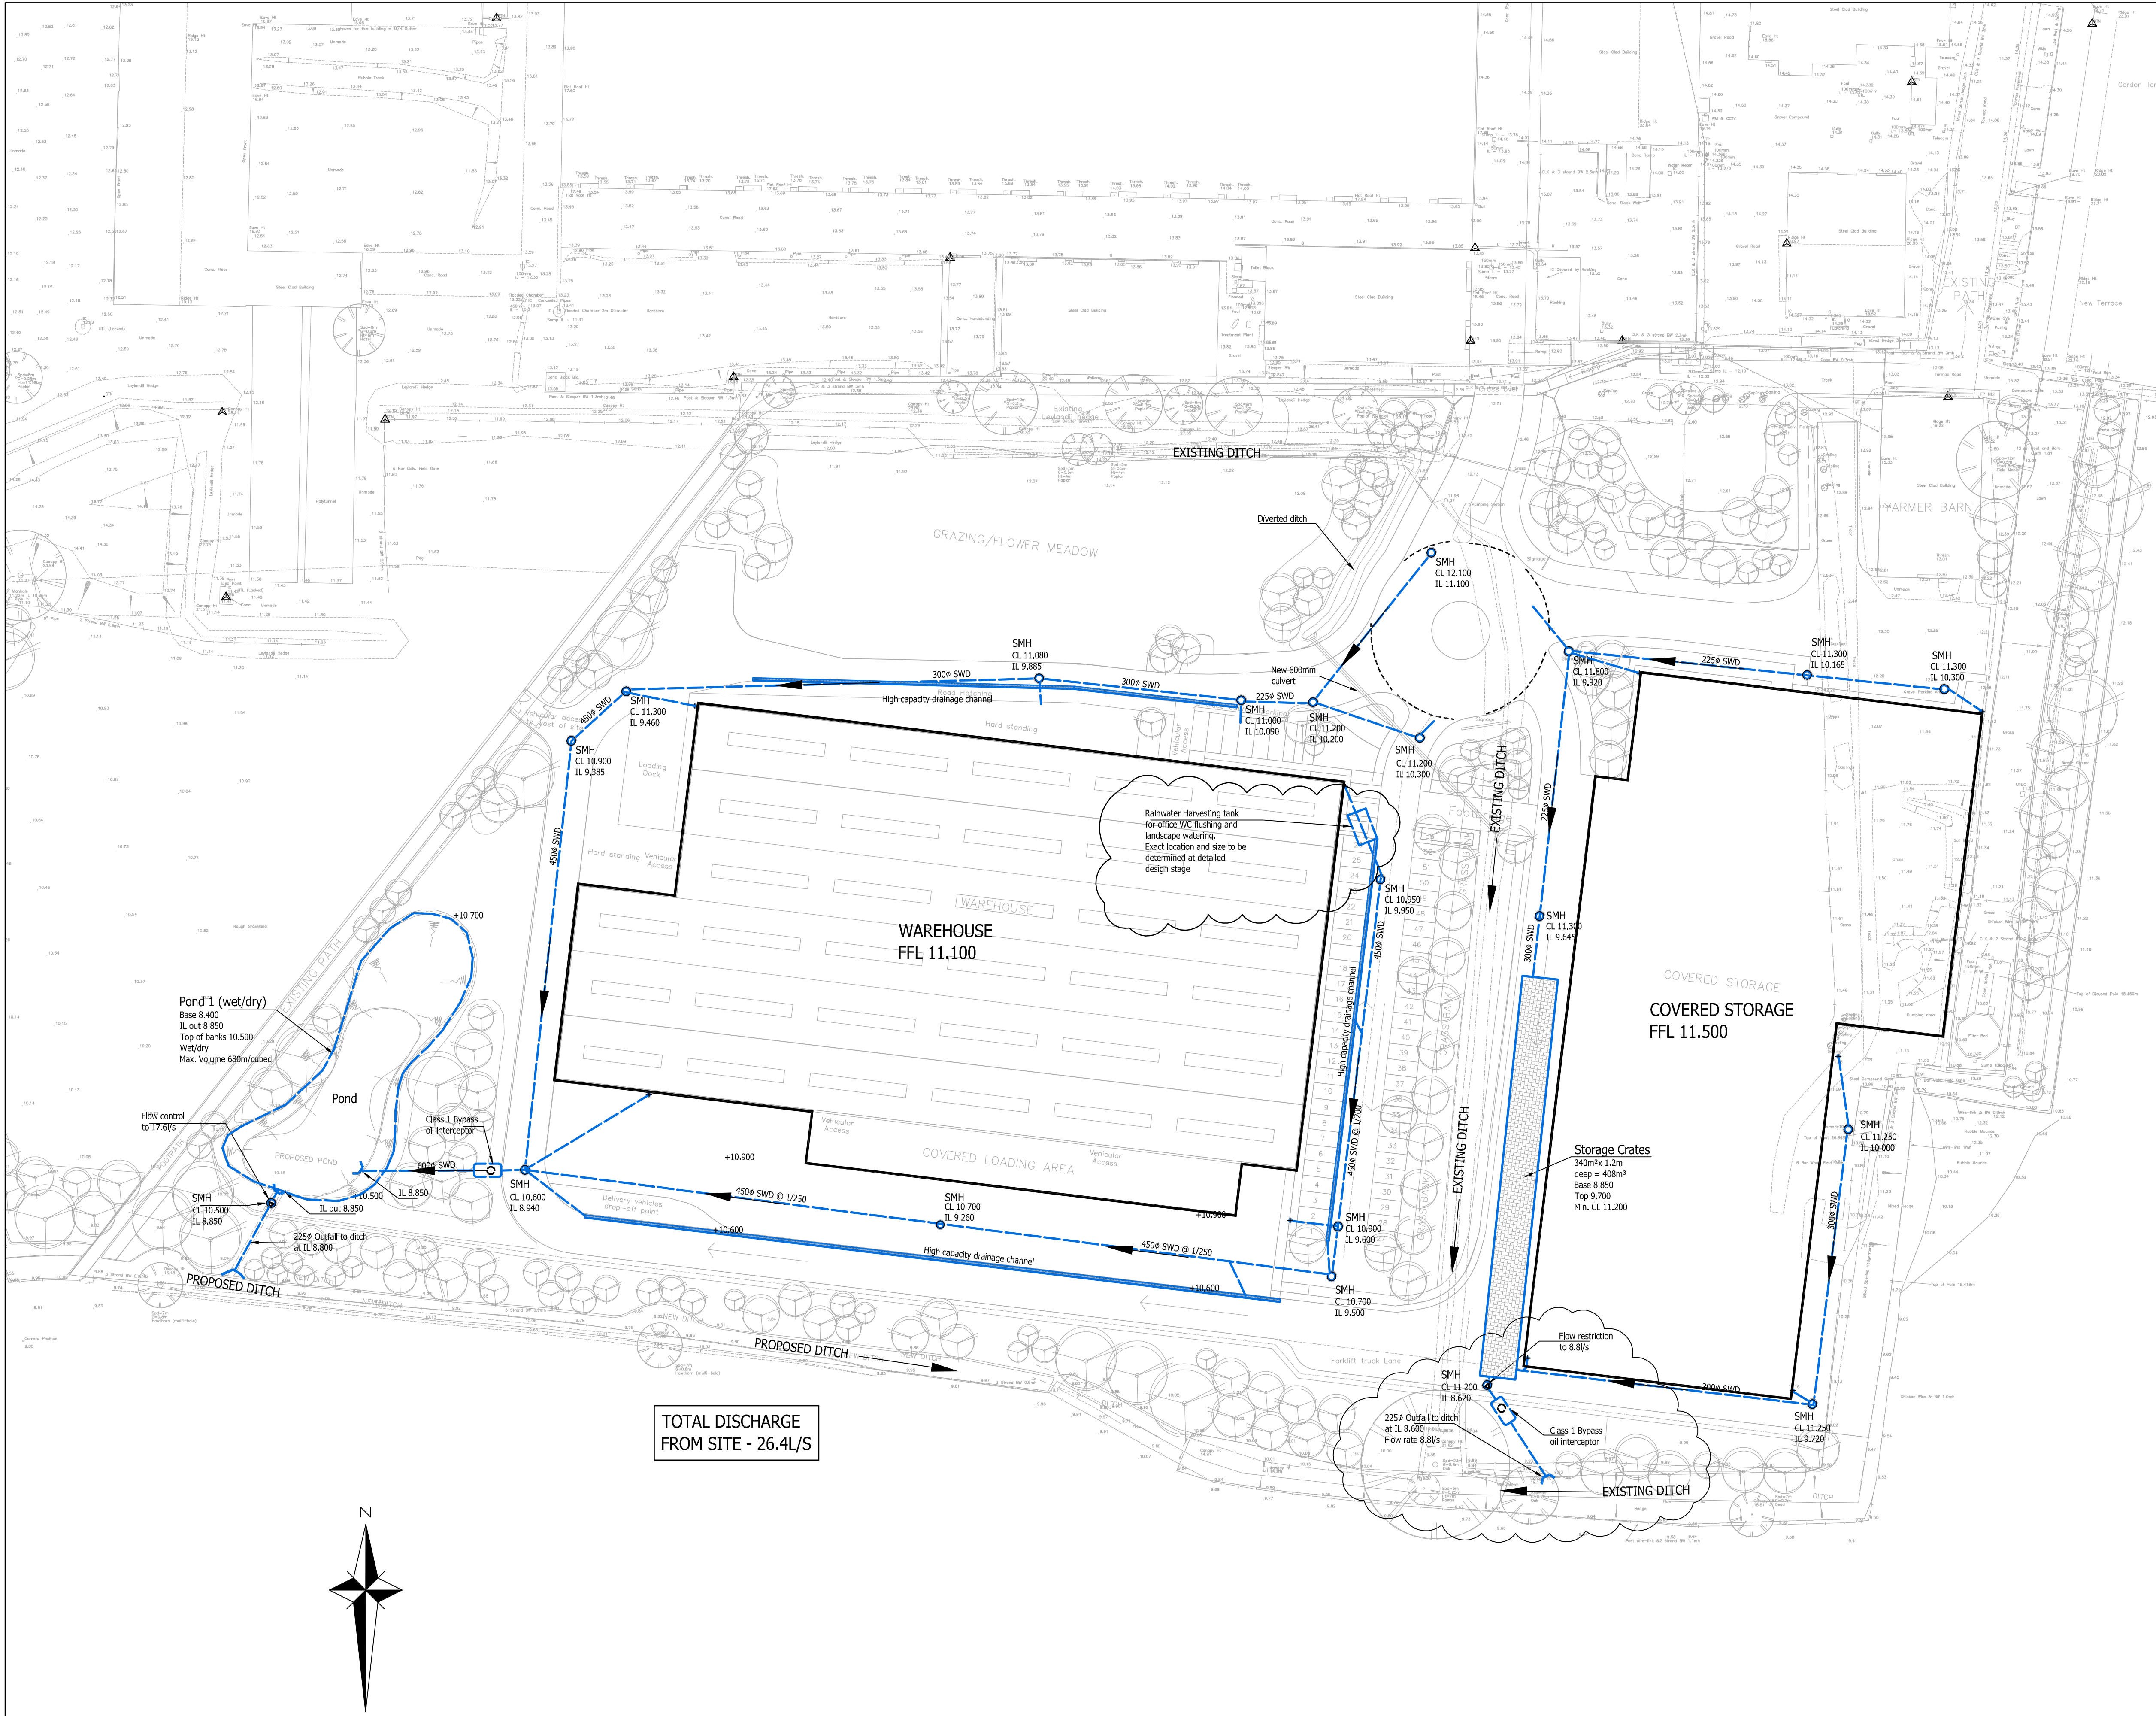

- GENERAL NOTES**
1. The location, size, depth and identification of existing services that may be shown or referred to on this drawing have been assessed from non intrusive observations, record drawings or the like. The contractor shall safely carry out intrusive investigations, trial holes or soundings prior to commencing work to satisfy himself that it is safe to proceed and that the assessments are accurate. Any discrepancies shall be notified to Millwood Consultants prior to works commencing.
 2. Tender or billing drawings shall not be used for construction or the ordering of materials.
 3. Do not scale. All dimensions and levels to be site confirmed.
 4. This drawing shall be read in conjunction with all relevant architects, consultants drawings and specifications, together with H&S plan requirements
 5. Copyright : This drawing must not be copied, amended nor reproduced without the prior written agreement of Millwood Consultants.
 6. All drawings specifications and recommendations made by millwood consultants are subject to Local Authority and other relevant Statutory Authorities approval. Any works or services made abortive due to the client proceeding prior to these approvals is considered wholly at the Clients risk. Millwood Consultants hold no responsibility for resulting abortive works or costs.

- KEY**
- SURFACE WATER DRAINAGE
 - FOUL DRAINAGE
 - FIC • Foul Plastic Inspection Chamber - D202.6
 - SIC • Surface Water Plastic Inspection Chamber - D202.6
 - FMH Foul Manhole
 - SMH Surface Water Manhole

Abbreviations	
D307.0	DETAIL NUMBER - SEE DRAINAGE DETAIL SHEET
FD	FOUL DRAIN
SWD	SURFACE WATER DRAIN
FWS	ADOPTED WATER AUTHORITY FOUL WATER SEWER
SWs	ADOPTED WATER AUTHORITY SURFACE WATER SEWER
MH	MAN-HOLE
IC	INSPECTION CHAMBER
CI	CAST IRON
VC	VITRIFIED CLAY
CONC	CONCRETE
PVC-U	POLYVINYL CHLORIDE - UNPLASTICISED
G	SMALL GULLY - D209.0
YG	YARD GULLY - D209.2
RG	ROAD GULLY - D208.1
CPS	CAR PARK GULLY - D208.2
DP	BELOW GROUND DRAIN POINT
SVP	SOIL VENT PIPE DROP
RP	EXTERNAL ROODING POINT D213.1
FFL	FINISHED FLOOR LEVEL
SSL	STRUCTURAL SLAB LEVEL
GL	GROUND LEVEL
CL	COVER LEVEL
IL	INVERT LEVEL
HL	HIGH LEVEL
BD	BACKDROP
CBS	Concrete Bed & Surround
Class S	Granular Bed & Surround
Class B	Granular Bed
FIC	450mm dia. foul inspection chamber - D202.6
SIC	450mm dia. surface water inspection chamber - D202.6
FAC	300mm dia. foul access chamber - D202.18
SAC	300mm dia. surface water access chamber - D202.18

E	Harvesting tank shown	23.5.13	MR	SC
D	Eastern outfall location revised to avoid Oak	25.4.13	MR	SC
C	Channel added.	11.12.12	MR	SC
B	Updated to latest architect's layout.	07.12.12	MR	SC
A	Updated to show single pond and tank relocated	23.11.12	MR	SC
Rev	Amendments	Date	Dsn	Chk
Status				
PRELIMINARY				
Client				
FARGRO				
Architect				
LIAM RUSSELL ARCHITECTS				
Project				
THE VINERY POLING				
Title				
SURFACE WATER DRAINAGE STRATEGY				
Date		Scale @ A1 1:500		
Base Layout Ref.		CAD File ref.		
Clients Ref.		Project Ref. 35201		
Millwood House Consultants Ltd Creating connections in construction Structures Contamination Civils				
The Studio, Millwood House, Littlehampton Road, Ferring West Sussex, BN12 6PG Tel: 00-44-1903-827749 E-mail: chris@millwoodconsultants.co.uk				
Drawing Number			Rev.	
35201-120			E	