


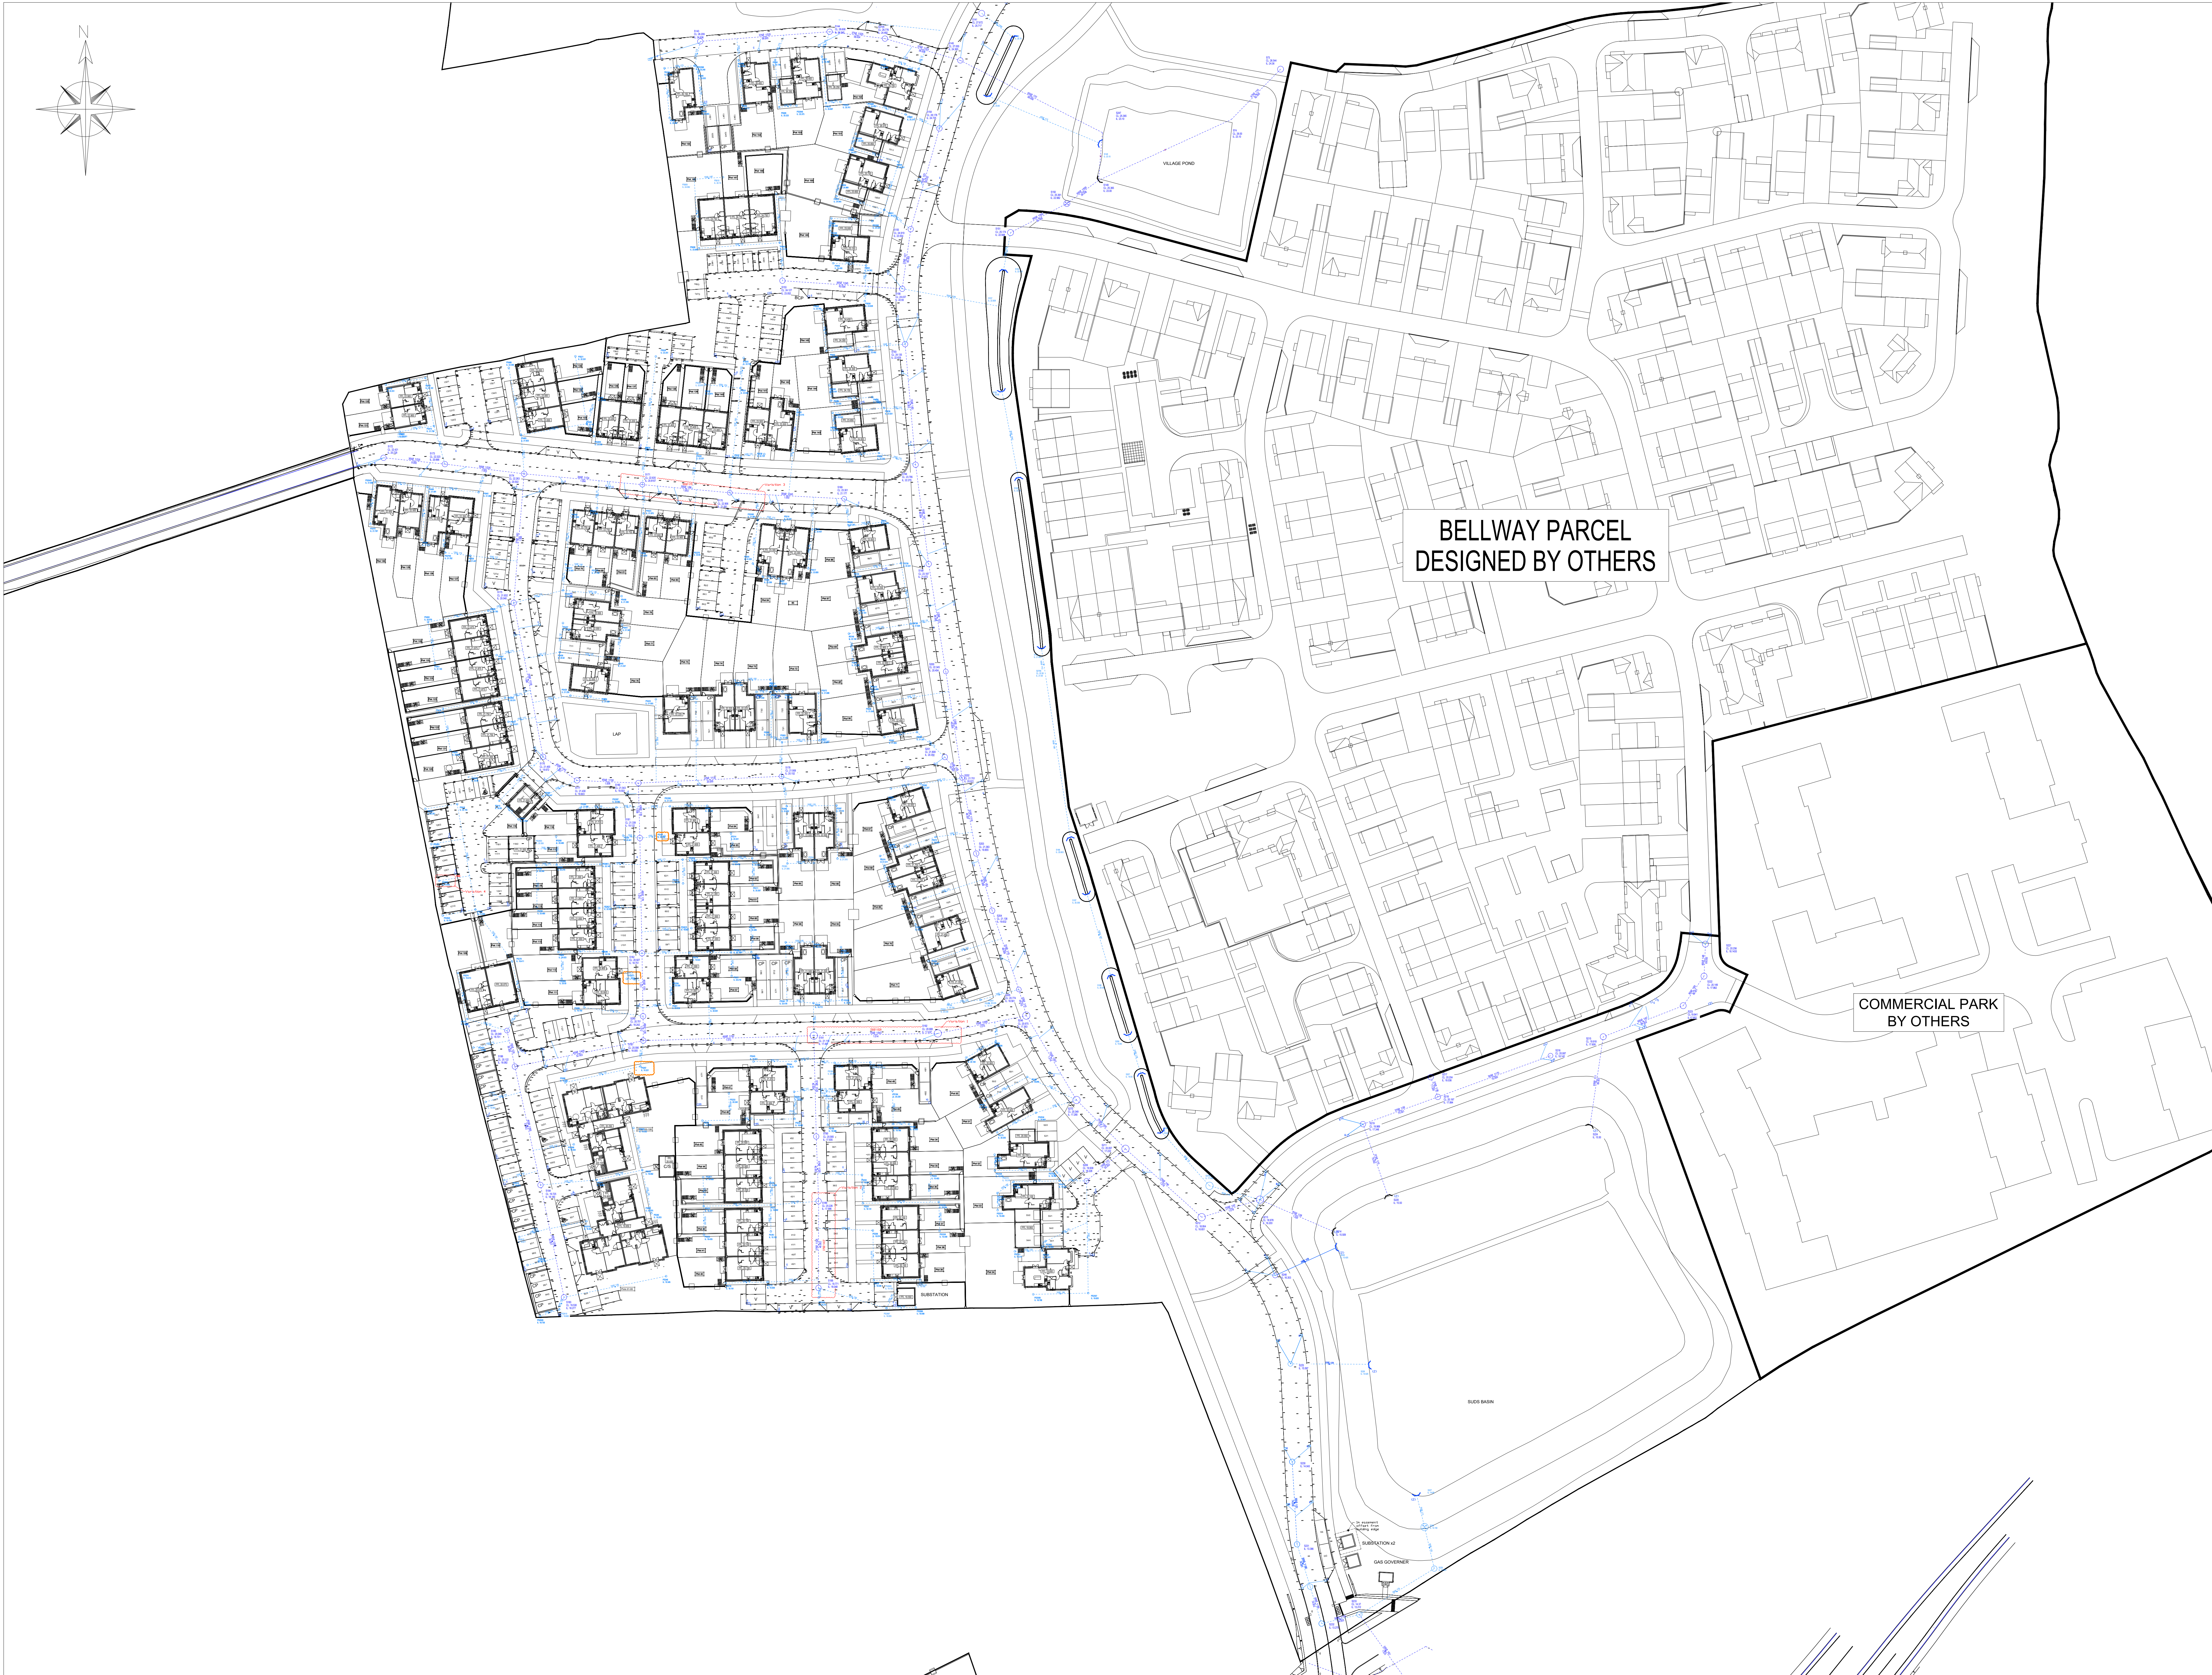

COMMERCIAL PARK
BY OTHERS

1. This as-built drawing has been produced to part discharge planning condition 29 from the outline planning consent A4018/10/OUT.
2. As-built information obtained from as-built topographic survey using a Leica TS12 total-station.
3. This drawing is to be read in conjunction with the Surface Water Ventrification Report 303.1A.SHC.501.
4. All paved finishes across the site are impermeable.
5. Variations to proposed has been highlighted and gradient marked in the drawing. Construction drawings should be referred to for gradients which has not been highlighted.

-  Adoptable Surface
-  Private Surface
-  Adoptable Surface Water Manhole
-  Private Surface Water Manhole
-  Road Gully (With 150mmØ Connection)
-  Variation Noted
-  CCTV Comment

Revisions[illegible]

Date	May 2025	Drawn by	Checked by
		M/W	K/W

Status	AS-BUILT
--------	----------

Dwg. No. 303 1B SHC 501 Rev. C