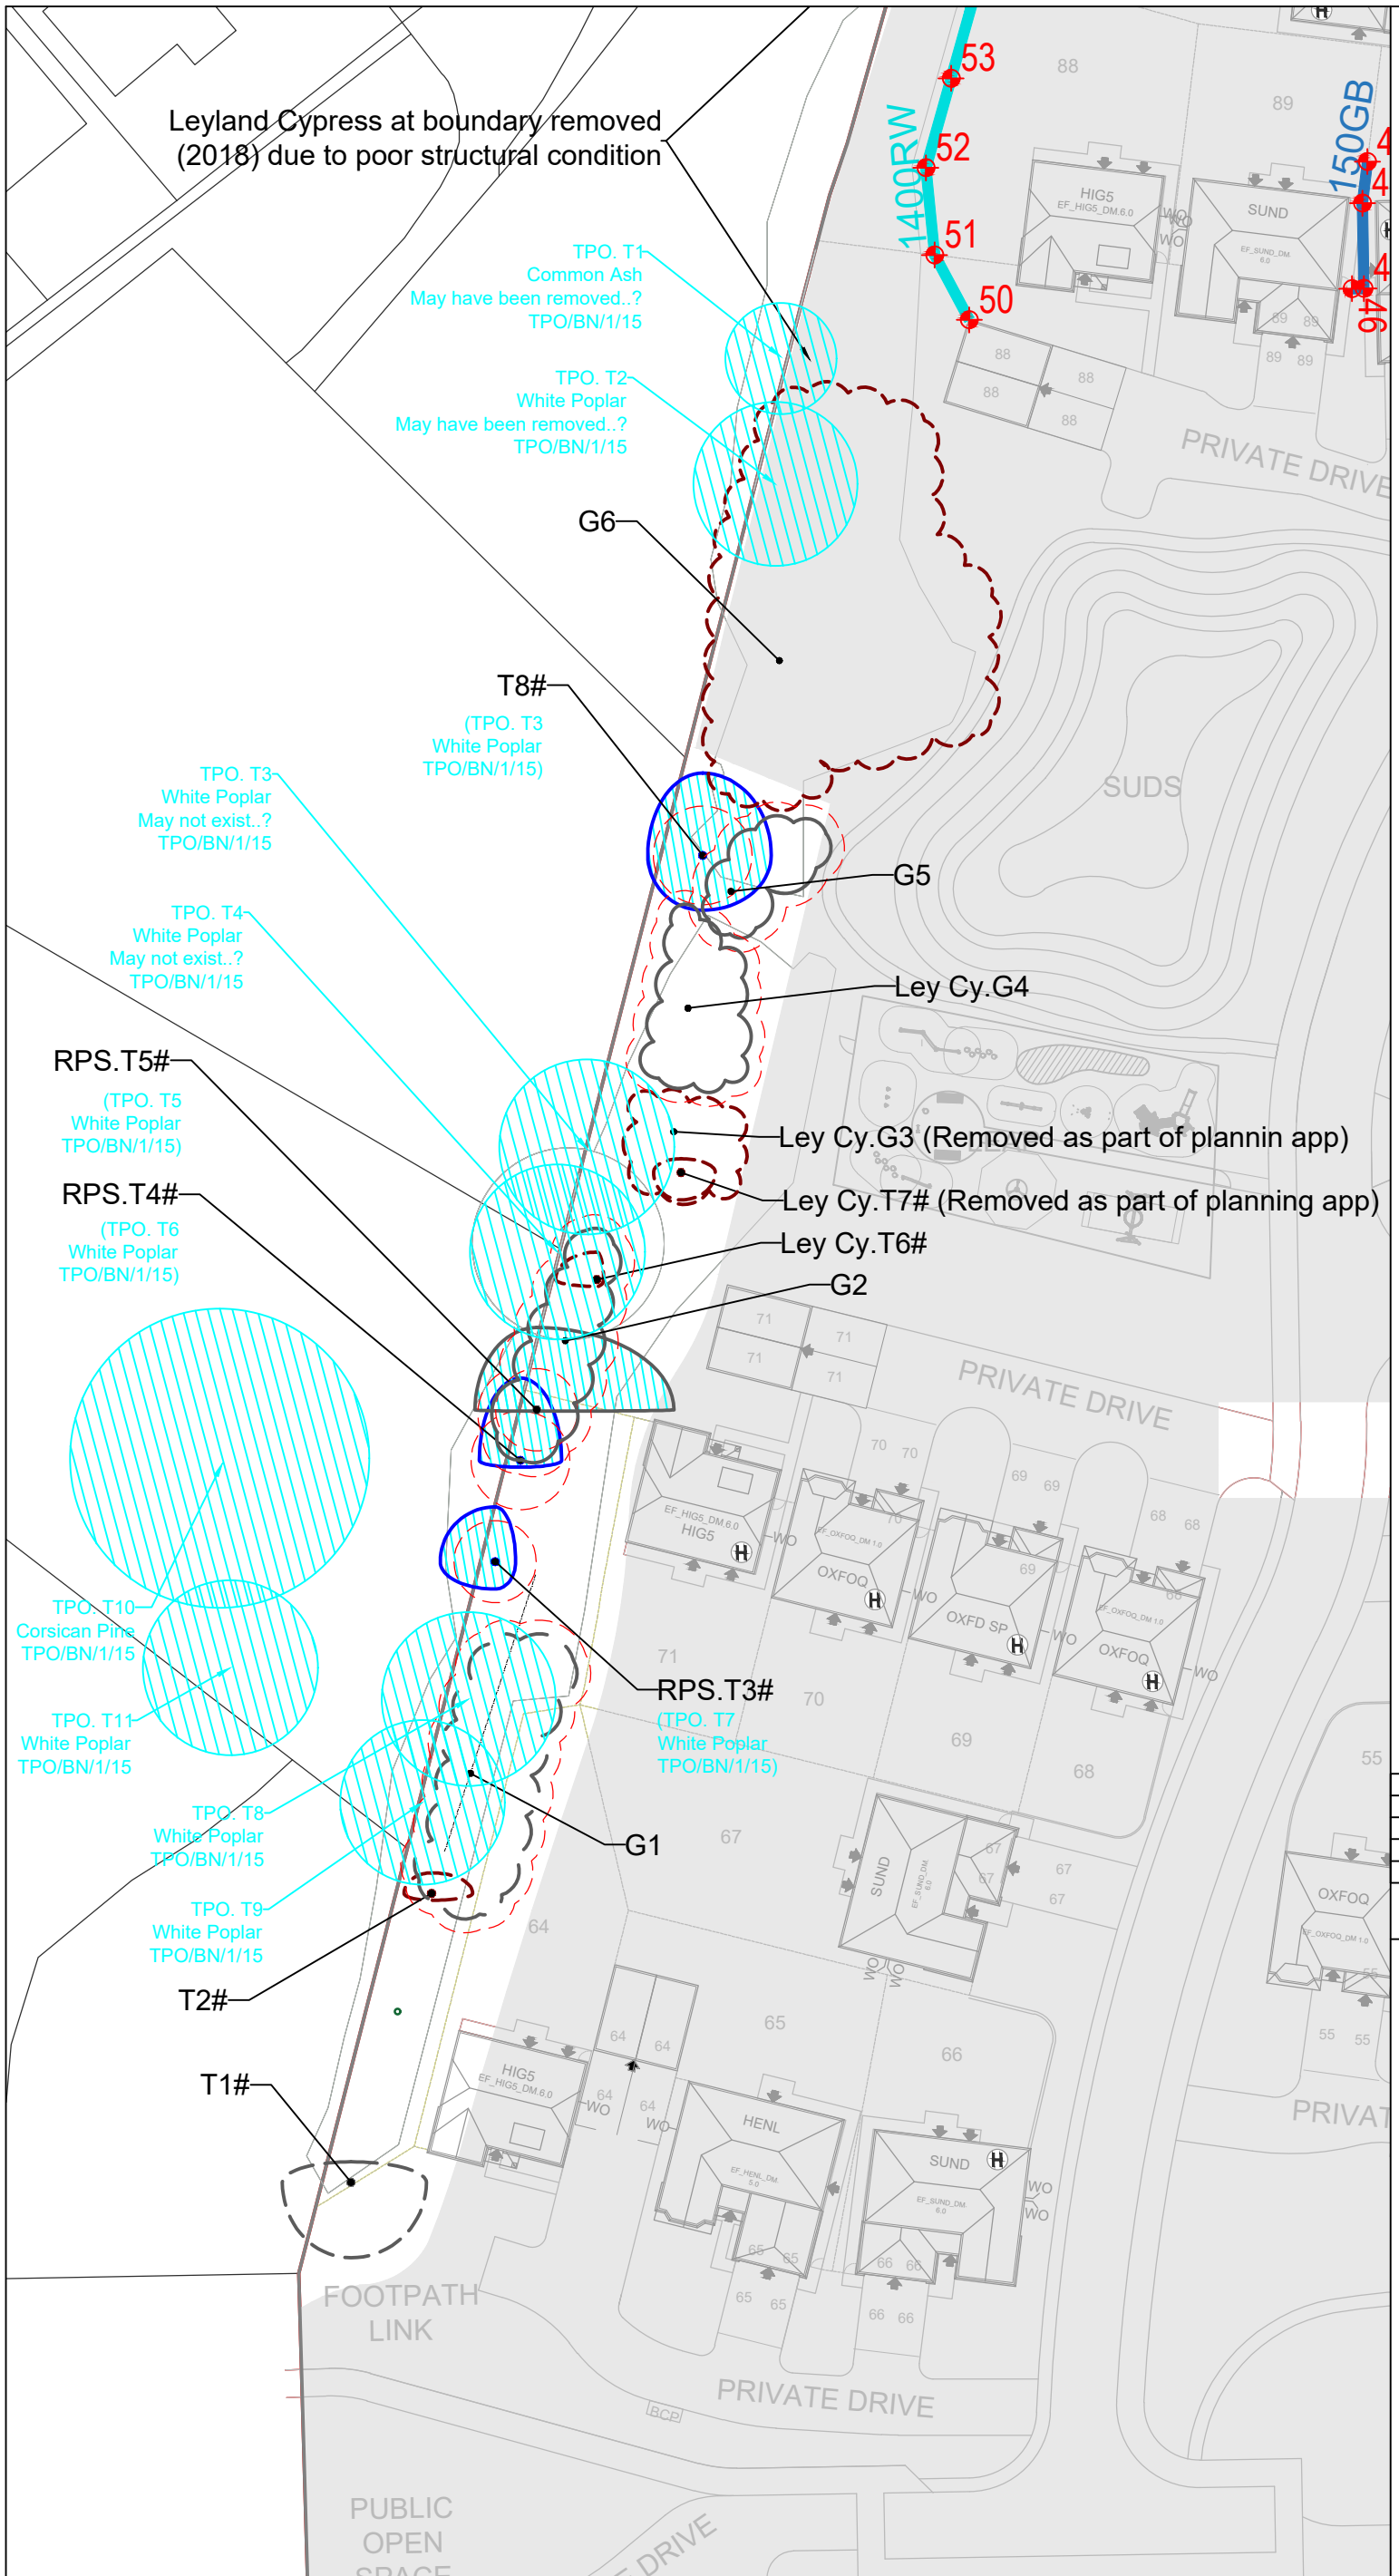

© 2019 RPS Group

Notes

1. This drawing has been prepared in accordance with the scope of RPS's appointment with its client and is subject to the terms and conditions of that appointment. RPS accepts no liability for any use of this document other than by its client and only for the purposes for which it was prepared and provided.
2. If received electronically it is the recipients responsibility to print to correct scale. Only written dimensions should be used.
3. Where applicable Ordnance Survey (c) Crown Copyright 2019 All rights reserved. Licence number 0100031673

Key

T1 — Tree with numbered reference. Canopy spread and BS5837:2012 tree quality category as shown below.

T1# — Tree (location estimated) with numbered reference. Canopy spread and BS5837:2012 tree quality category.

G1 — Vegetation group with numbered reference. Canopy extents and BS5837:2012 tree quality category as shown below.

BS 5837:2012 Tree Quality Categories - Table 1

- Category A - High quality
- Category B - Moderate quality
- Category C - Low quality
- Category U - Unsuitable for retention

Root protection area (RPA) Calculated in accordance with Section 4.6 - BS5837:2012

Tree to be removed with numbered reference. Canopy spread and BS5837:2012 tree quality category.

Vegetation group or hedge to be removed with numbered reference. Canopy spread and BS5837:2012 tree quality category.

T1 (G1) — Tree protected by Arun District Council Tree Preservation Order No.TPO/BN/1/15. Bracketed number reference relates to the TPO Schedule.

NOTES:

- Refer to RPS Tree Survey Report & Schedule for further details.
- Survey based on a visual inspection from the ground and is not intended as a full arboricultural inspection.
- Plan produced in accordance with recommendations set out in BS 5837:2012 - 'Trees in Relation to design, demolition and construction'.
- Due to the legal protection afforded to breeding birds vegetation removal should not take place during the bird nesting period; generally, although not restricted to, March - August inclusive.
- Survey based upon topographic survey produced by produced by M.J. Zara Associates of Lewes, East Sussex in November 2011(ref 7054).

Rev	Description	Date	Initial	Checked
C	TPO information added	11.20	JMB	SK
B	Client amends, retaining walls omitted.	10.20	DC	DC
A	Replanting works added	11.18	DC	DC

Scale Bar

0m 25m 50m

MAKING COMPLEX EASY

Lakesbury House, Hiltingbury Road, Chandlers Ford, Hampshire SO53 5SS

T: 02380 810 440 **E:** rpsso@rpsgroup.com

Client: Redrow Homes

Project: Lake Lane, Barnham

Title: Estimated location TPO'ed trees

Status	Drawn By	PM/Checked by
For information	JMB	JB
Job Ref	**Scale @ A3**	**Date Created**
JSL2477	1:500	01/11/2018
Drawing Number		**Rev**
730		C

rpsgroup.com

P:\2400 Series\JSL2477 - Lake Lane, Barnham\Tech\Acad\Current\JSL2477_730 (TPO Mark Up).dwg

ARUN DISTRICT COUNCIL