

ROAD SIGNS SCHEDULE									
No.	TSRCD Ref.	Size	Mount Height	Sign Face Material	Illumination	Pole Dia	Foundation	Position	Description
S1	965	50mm x 40mm	2300mm	Reflectivity to BS EN 12899 Class Ref 2	None	On same post as S2	-	Back of footway at end of shared footway/cycleway adjacent to sub-station	Proposed end of shared pedestrian & cycle route back to back with sign S2
S2	956	450mm	2300mm	Reflectivity to BS EN 12899 Class Ref 2	None	76mm post	900 x 900 x 600	Back of footway at end of shared footway/cycleway adjacent to sub-station	Proposed shared pedestrian & cycle route

- LEGEND**
- VEHICLE CROSSOVER
 - BITUMINOUS CARRIAGEWAY SURFACING ADOPED ROADS
 - PARKING COURT SURFACING
 - PERMEABLE PRIVATE ACCESS SURFACING
 - PERMEABLE NO-DIG ZONE SURFACING
 - BLOCK PAVING DRIVE/CAR PARKING BAY CONSTRUCTION
 - BLOCK PAVING CARRIAGEWAY CONSTRUCTION ADOPED ROAD
 - ADOPED FOOTWAY/CROSSOVER BLOCK PAVING CONSTRUCTION
 - BITUMINOUS FOOTWAY CONSTRUCTION
 - FLAG PAVING
 - VERGE
 - SELF-SETTING GRAVEL FOOTPATH
 - TACTILE PAVING
 - PCC HED Kerbs with 125mm Upstand
 - PCC BN Kerbs with 50mm Upstand unless noted otherwise
 - PCC BN Kerbs with 25mm Upstand
 - PCC BN DROPPED KERB with 25mm Upstand
 - Flush BN Kerbs (0-6mm Upstand)
 - PCC Flush Edging
 - Timber edging to 750-850 across

Note : Changes in Kerb Heights are to be made with suitable Transition Kerbs

- +05.050 PROPOSED FINISHED LEVELS
- +05.050(x) EXISTING LEVELS

- EXPOSED FACE
- BRICK RETAINING WALL
- GR
- GRAVEL BOARD
- RAISED DPC
- EXISTING DITCH/WATERCOURSE
- ADAPTABLE STREET LIGHTING COLUMN REFER TO CDS DRAWING INC 20200
- PROPOSED TRAFFIC SIGN REFER TO SCHEDULE FOR DETAILS
- TACTILE PAVING WITH DROPPED CROSSING MAX KERB HEIGHT 6mm 2 or 3 mm deep (see layout) 900mm wide

- REFER TO ARCHITECT FOR REAR/ACCESS PATH POSITIONS
- SITE BOUNDARY
 - DIP STOP THROUGH PERMEABLE PAVING REFER TO DETAILS ON Z10. ALSO REFER TO UTILITIES SERVICE PLANS FOR EXACT SERVICES LOCATIONS

DOOR WIDTH	PATIO WIDTH	DEPTH
3025	4200	1800
3385	4200	1800
3046	3600	1800
2823	3600	1800
2485	3000	1800
1800	2400	1800
1585	2400	1800














ROAD SIGN NOTES

Road signs and markings refer to TSRGD 2016. Road marking to be carried out in accordance with Series 1200 of the specification for highway works

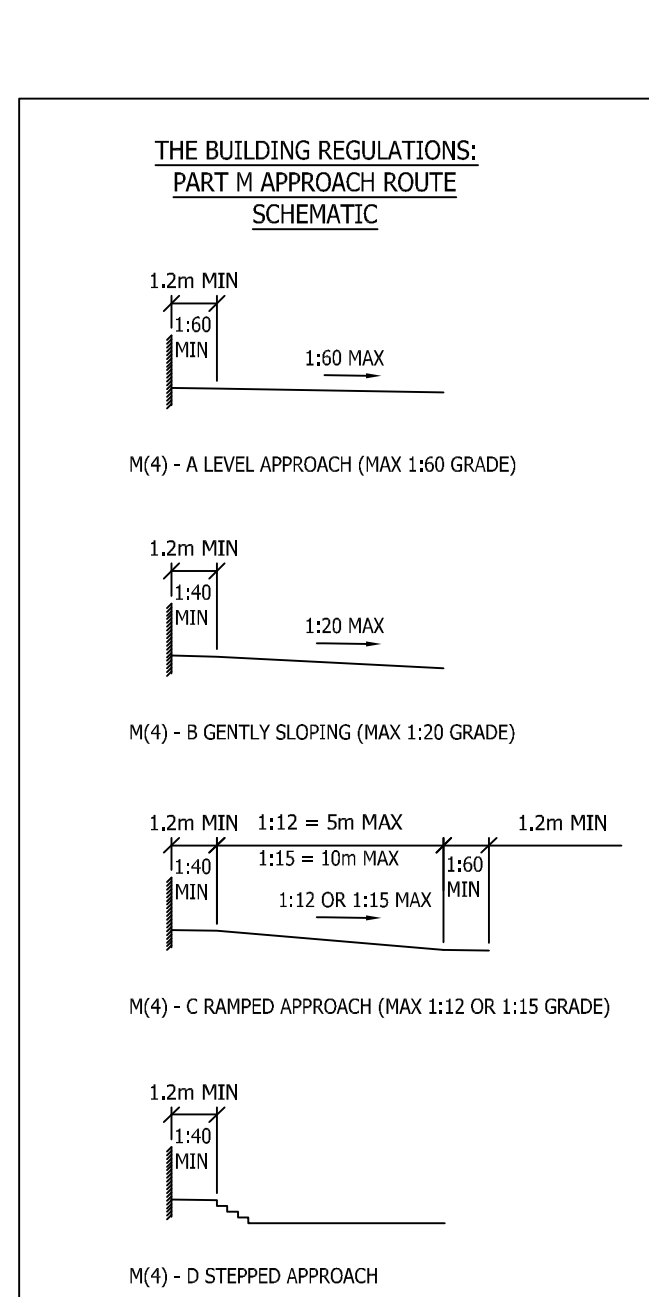

DESIGN NOTES

- CONTRACTOR TO ESTABLISH LOCATIONS OF ALL EXISTING SERVICES PRIOR TO COMMENCING. STAFF DIVERSIONS TO BE CO-ORDINATED BY OTHERS WHERE NECESSARY.
- EXISTING TREES TO BE PROTECTED WHERE EXCAVATIONS RUN CLOSE.
- REFER TO DRAWING 2103 & 2104 FOR EXTERNAL WORKS DETAILS.
- CBR TESTS TO BE TAKEN ON SITE TO CONFIRM PROPOSED CARRIAGEWAY CONSTRUCTION.
- RAISED DPC TO BE INSTALLED WHERE PROPOSED EXTERNAL GROUND LEVELS ARE HIGHER THAN 150MM BELOW DPC.
- ADAPTABLE CARRIAGEWAY CONSTRUCTION SUBJECT TO APPROVAL BY WSCC COUNTY COUNCIL HIGHWAYS.

WEST SUSSEX COUNTY COUNCIL HIGHWAYS NOTES:


No works shall commence within the existing public highway until the Agreement is signed.

- Any soft spots within the proposed highway shall be dug out and the void backfilled in layers up to formation level with selected granular material as directed and to the satisfaction of the Highways Inspector.
- All fill material up to foundation level of the proposed highways to be approved and compacted in layers as directed and to the satisfaction of the Highways Inspector.
- Any damage caused to the existing highway during the course of the works to be repaired as directed and to the satisfaction of the Highways Inspector and/or Area Engineer.
- Continuity of access to occupied areas to be maintained to satisfaction of Highways Inspector, Area Office Engineer and/or Local Authority.
- Any abandoned/redundant pipes and chambers that fall within the proposed highway shall be grubbed up and the void backfilled in layers up to formation level of the carriageway with selected granular material or permanently filled with concrete (or similar filler).
- All redundant connections in existing manholes/chambers that are affected by the works shall be sealed and the benching made good as directed and to the satisfaction of the Highways Inspector and/or utility company involved.
- Any existing live drains, sewers, ducts, cables, etc. that will pass under the proposed highway shall be surveyed, probed, traced, noted, jetted, etc., etc. to ascertain their structural condition and suitability to fall within the new highway. If deemed necessary, special protection and/or replacement may be required as directed and to the satisfaction of the Highways Inspector, Area Engineer and/or Utility Company involved.
- Developer/Contractor to provide suitable and effective wheel washing facilities to prevent mud from being conveyed onto the public Highway and to provide the means to clean the highway to the satisfaction of the Highways Inspector, Area Engineer and/or Local Authority.
- No concrete to be poured or laid in temperatures below 5deg C on a falling max/min thermometer or before the temperature reaches 5deg C on a rising max/min thermometer (to be provided by the Contractor and displayed in a position agreed by the Highways Inspector).
- All road signs and markings to comply with the Traffic Signs Manual.
- All road markings to be thermoplastic.
- Contractor to comply with Chapter 8 of the Traffic Signs Manual 2009.
- Refer to WSCC 278/38 Highway Agreement Standard Details drawings 01-21 and revisions thereof.
- All adaptable Highway works to be carried out in accordance with the DfT Specification of Highway Works or as amended by the West Sussex County Council Standard Details (2015) - both available on the Internet.

- Any existing live manholes, chambers, boxes, etc. that will be located within the proposed highway shall be surveyed to ascertain their structural condition and suitability to fall within the new highway. If deemed necessary, special protection and/or replacement may be required as directed and to the satisfaction of the Highways Inspector, Area Engineer and/or Utility Company involved.

GENERAL NOTES:

- All dimensions to be checked on site. All details and dimensions relating to sub-construction or suppliers work must be checked and agreed between the sub-contractor or supplier and the main contractor.
- This drawing is to be read in conjunction with all relevant architectural, services and engineers drawings and specifications.
- The location, size, depth and identification of existing services that may be shown or referred to in this drawing have been assessed from non-intrusive observations, record drawings or the like. The contractor shall advise any not intrusive investigations, trial holes or soundings prior to commencing work to satisfy himself that it is safe to proceed and that the assessments are accurate. Any discrepancies shall be notified to the client prior to works commencing.
- Tender or billing drawings shall not be used for construction or the ordering of materials.
- Do not scale. All dimensions and levels to be confirmed.
- Copyright : This drawing must not be copied, amended nor reproduced without the prior written agreement of the client.

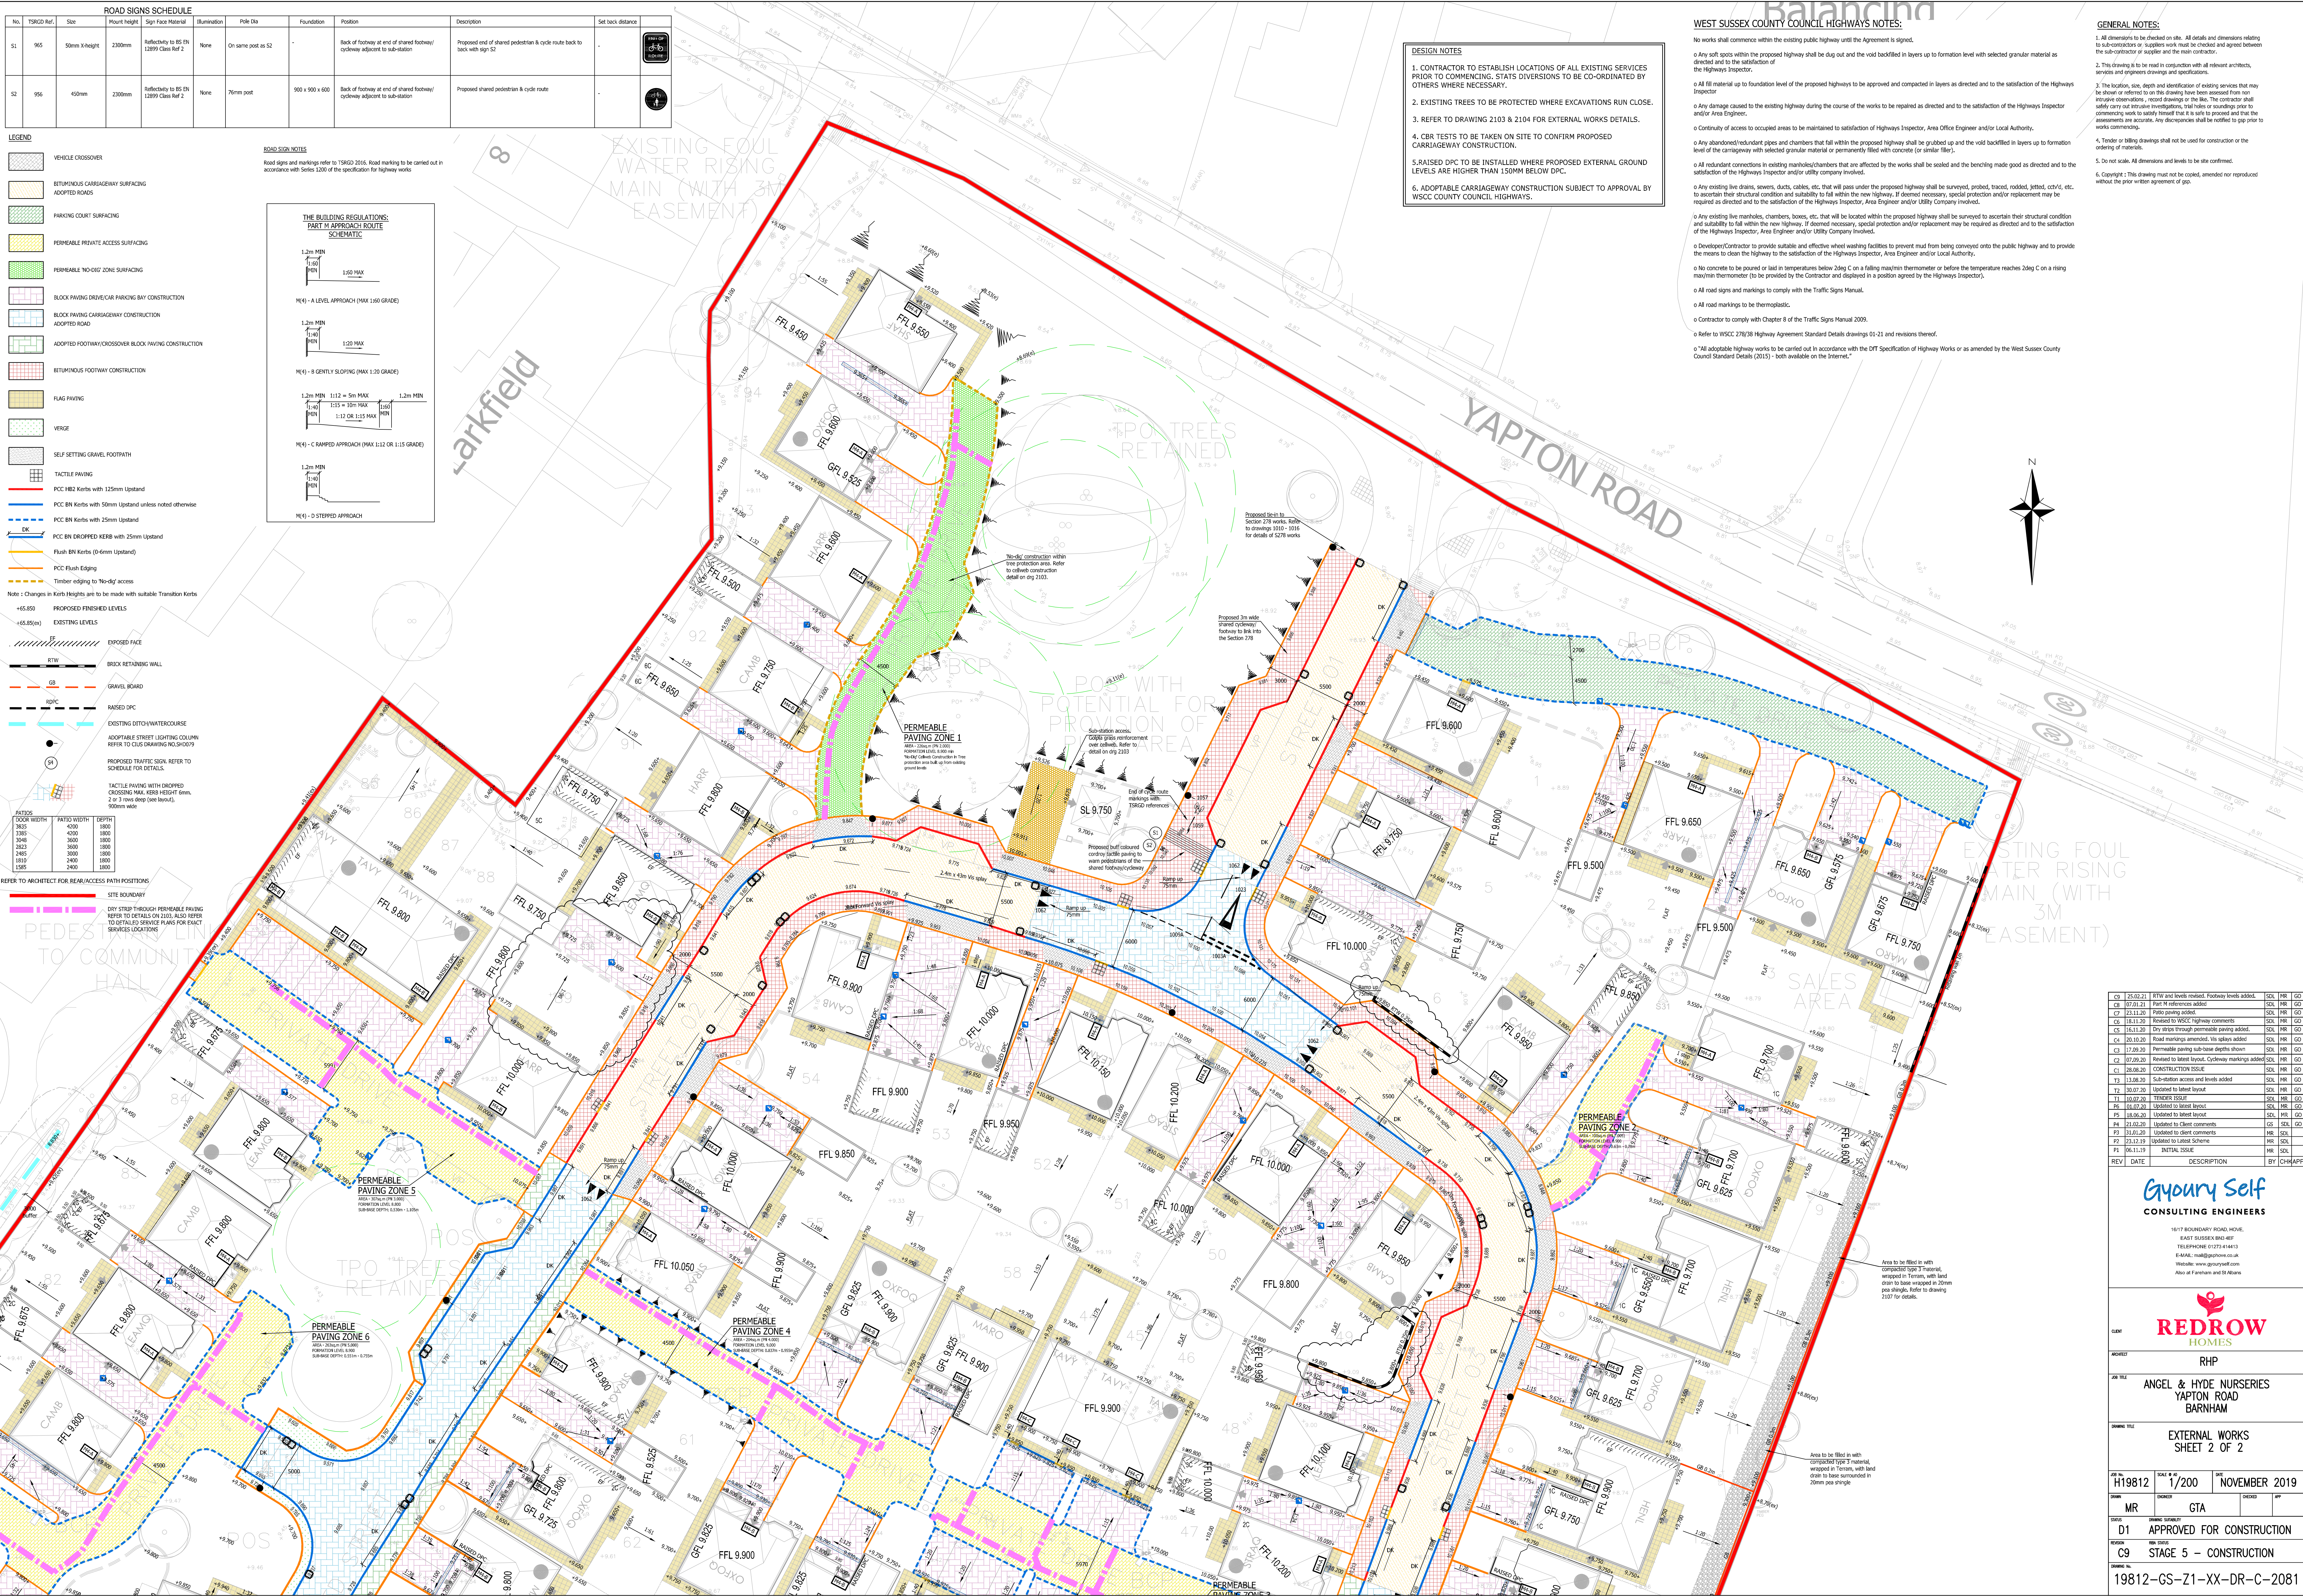

REV	DATE	DESCRIPTION	BY	CHK	APP
C9	25.02.21	RTW and levels revised. Footway levels added.	SCL	HR	GO
C8	07.02.21	Part M references added.	SCL	HR	GO
C7	03.11.20	Paving paving added.	SCL	HR	GO
C6	18.11.20	Revised to WSCC highway comments.	SCL	HR	GO
C5	16.11.20	Dry trench through permeable paving added.	SCL	HR	GO
C4	09.10.20	Road markings amended. Via signs added.	SCL	HR	GO
C3	17.09.20	Permeable paving sub-base depths shown.	SCL	HR	GO
C2	07.09.20	Revised to latest layout. Cycleway markings added.	SCL	HR	GO
C1	28.08.20	CONSTRUCTION ISSUE	SCL	HR	GO

Gyuary Self
CONSULTING ENGINEERS

1617 BOUNDARY ROAD, HOVE,
EAST SUSSEX BN1 4EF
TELEPHONE: 01323 494413
E-MAIL: mail@gyuaryself.co.uk
Website: www.gyuaryself.com
Also at Farnham and St Albans

REDROW
HOMES

RHP

ANGEL & HYDE NURSERIES
YAPTON ROAD
BARNHAM

EXTERNAL WORKS
SHEET 2 OF 2

H19812
 1/200
 NOVEMBER 2019

MR
 CTA

D1
 APPROVED FOR CONSTRUCTION

C9
 STAGE 5 - CONSTRUCTION

19812-GS-Z1-XX-DR-C-2081