© 2012 RPS Group

Notes

1. This drawing has been prepared in accordance with the scope of RPS's appointment with its client and is subject to the terms and conditions of that appointment. RPS accepts no liability for any use of this document other than by its client and only for the purposes for which it was prepared and provided.
2. If received electronically it is the recipients responsibility to print to correct scale. Only written dimensions should be used.

N

## Key

- Site boundary.
- T1 — Tree with numbered reference. Canopy spread and BS5837:2012 tree quality category as shown below.
- G1 — Vegetation group with numbered reference. Canopy extents and BS5837:2012 tree quality category as shown below.
- H1 — Hedge with numbered reference. Width and BS5837:2012 tree quality category as shown below.

BS 5837:2012 Tree Quality Categories - Table 1

- Category A - High quality
- Category B - Moderate quality
- Category C - Low quality
- Category U - Unsuitable for retention

- T1 G1 — Tree group protected by Tree Preservation Order No.(TPO/BN/1/13)
- Root protection area (RPA) Calculated in accordance with Section 4.6 - BS5837:2012
- Tree to be removed with numbered reference. Canopy spread and BS5837:2012 tree quality category.
- Vegetation group or hedge to be removed with numbered reference. Canopy spread and BS5837:2012 tree quality category.
- Tree to be removed in addition to approved Reserved Matters layout ref: BN/21/15
- Temporary protective fencing in accordance with Section 6.2 - BS5837:2012. "as built" record via topo survey dated Dec 2016

NOTES:

- Refer to RPS Tree Survey Report & Schedule for further details.
- Survey based on a visual inspection from the ground and is not intended as a full arboricultural inspection.
- Plan produced in accordance with recommendations set out in BS 5837:2012 - 'Trees in Relation to design, demolition and construction'.
- Survey based upon topographic survey produced by produced by M.J. Zara Associates of Lewes, East Sussex in November 2011(ref 7054)
- Pedestrian/ vehicular emergency access routes to be maintained at all times.
- All works to conform with requirements of:
  BS 3998:2010 - Tree Works
  BS 5837:2012 - Trees in relation to design, demolition and construction

Key plan NTS

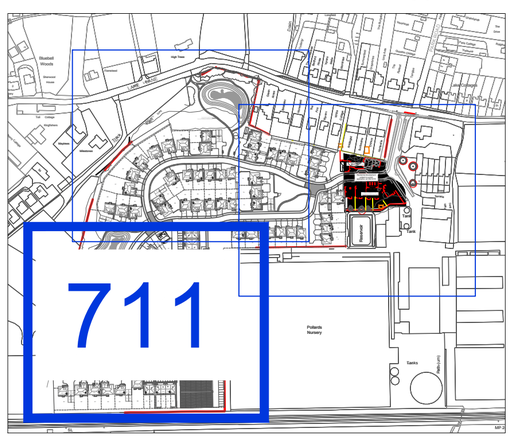


| Rev | Description | Date | Initial | Checked |
|---|---|---|---|---|
| E | Minor amends | 07/02/2018 | JB | JB |
| D | New layout referenced | 17/08/2017 | DC | DC |
| C | Additional trees surveyed | 11/ 2016 | JMB | CC |
| B | Site layout updated & updated with on-site Tree/vegetation removal, Planning ref added | 07/ 2016 | SH | DC |
| A | Planning refs added | 11.16 | DC | DC |

RPS

Lakesbury House, Hiltingbury Road, Chandlers Ford, Hampshire. SO53 5SS

T: +44(0)2380 810 440 E: rpsso@rpsgroup.com F: +44(0)2380 810 449

Client: Redrow Homes

Project: Lake Lane, Barnham

Title: Tree Protection Plan (Sheet 2 of 3)

| Status | Drawn By | PM/Checked by |
|---|---|---|
| For Comment | SH | CC |
| Job Ref | Scale @ A2 | Date Created |
| JSL 2477 | 1:500 | 17/12/2015 |

Drawing Number: 711

Rev: E

rpsgroup.com