




LOCATION PLAN @ 1:1250
 licence No. 100047474
 Application site shown in red

Scale 1:1250
 0 50000 100000

N.B
 No part of new construction
 is to over hang the
 boundary with no. 61
 Dimensions shown are to
 the walls.

PROPOSED SITE PLAN @ 1:200

Scale 1:200
 0 2m 4m 6m 8m 10m

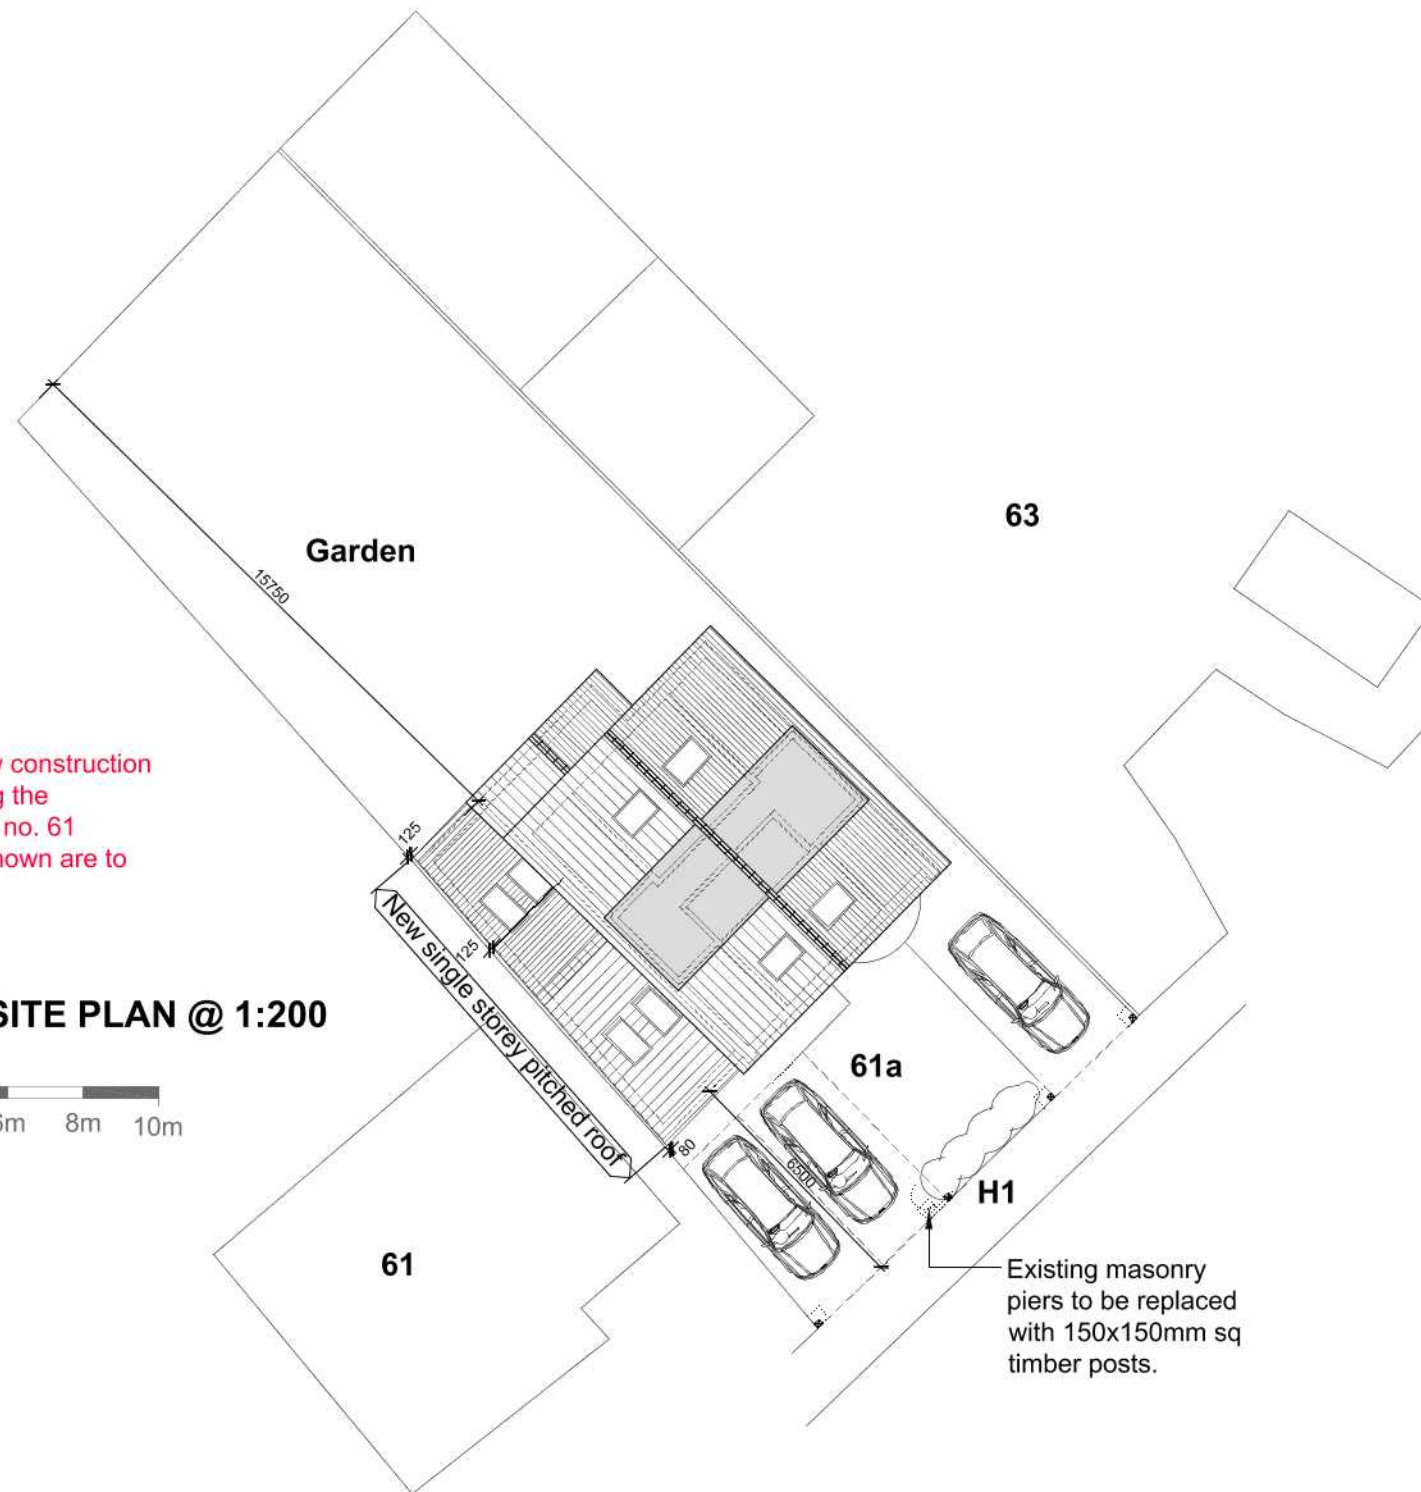

NOTES:

ALL DIMENSIONS TO BE CHECKED
 ON SITE AND VERIFIED PRIOR TO COMMENCING
 WORKS/MANUFACTURE. ANY DISCREPANCIES TO BE
 REPORTED TO NOUVEAU ARCHITECTURE

THIS DRAWING IS PROTECTED BY COPYRIGHT. IT
 MAY NOT BE REPRODUCED IN ANY FORM OR BY ANY
 MEANS FOR ANY PURPOSE WITHOUT THE WRITTEN
 PERMISSION OF NOUVEAU ARCHITECTURE

**ISSUED FOR PLANNING PURPOSES
 ONLY**

A	09.09.19	Site Plan - dimensions added from masonry to boundaries
---	----------	---

Rev	Date	Description
-----	------	-------------

Revisions		
-----------	--	--

CLIENT:

Mr & Mrs Reed
 61a Annandale Avenue
 Bognor Regis
 PO21 2ET

PROJECT:

Garage Conversion
 61a Annandale Avenue
 Bognor Regis
 PO21 2ET

DRAWING TITLE:

Proposed Site Plan & Location Plan

PLANNING APPLICATION

NOUVEAU ARCHITECTURE

9 Bere Lane
 Knowle Village
 Hampshire
 PO17 5GL
 Tel: 01329 833396
 Email: info@nouveau-architecture.co.uk
 Web: www.nouveau-architecture.co.uk



SCALE: As shown @ A3

DATE: July 2019

DRAWN: CW

CHECKED BY:

DRAWING NO:

N307

PL01

A

ARUN DISTRICT COUNCIL BR/251/19/HH