


ARUN DISTRICT COUNCIL BR/359/10/

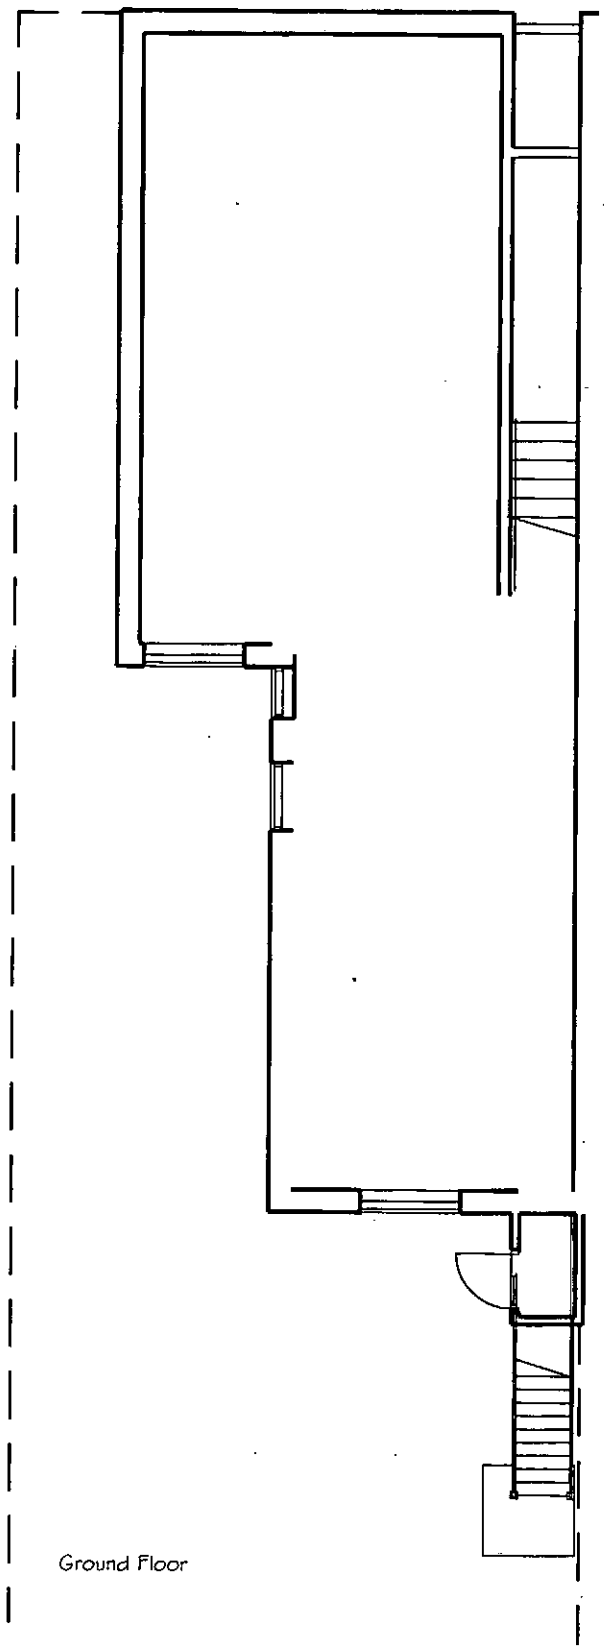


Ground Floor

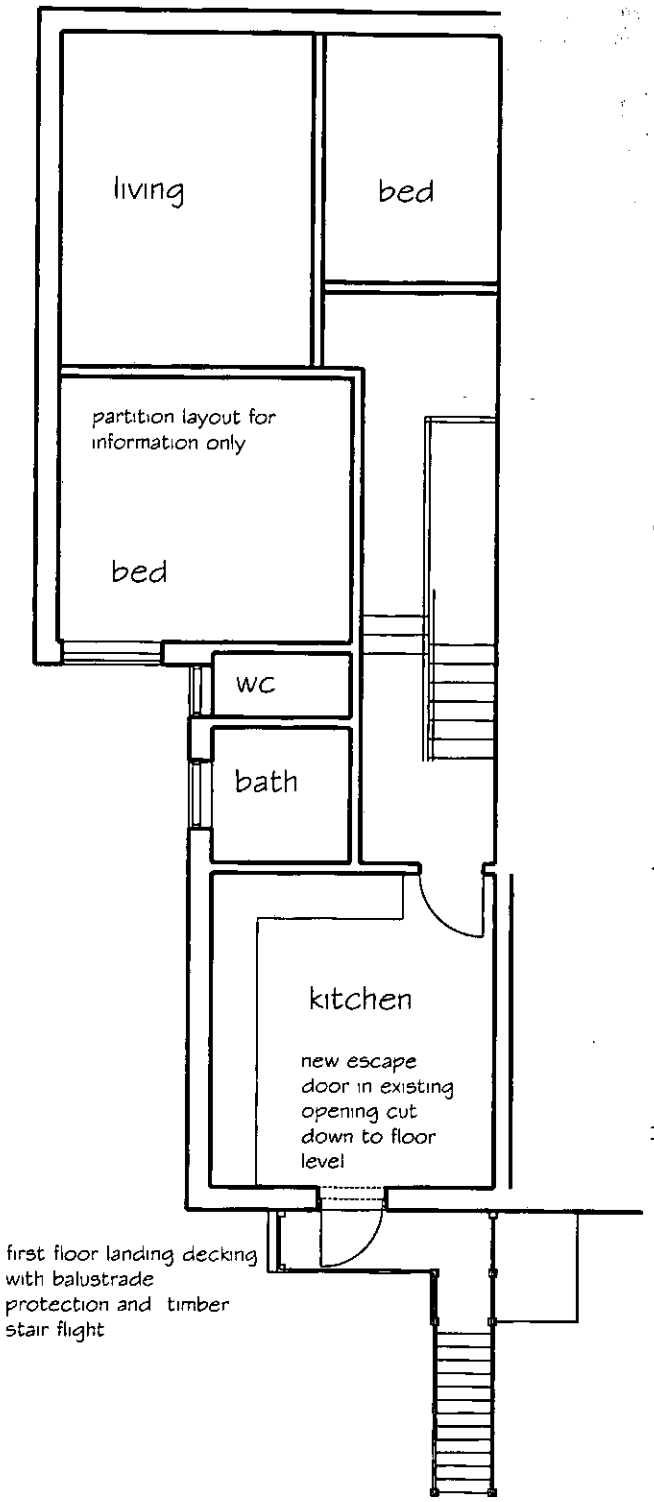


First Floor

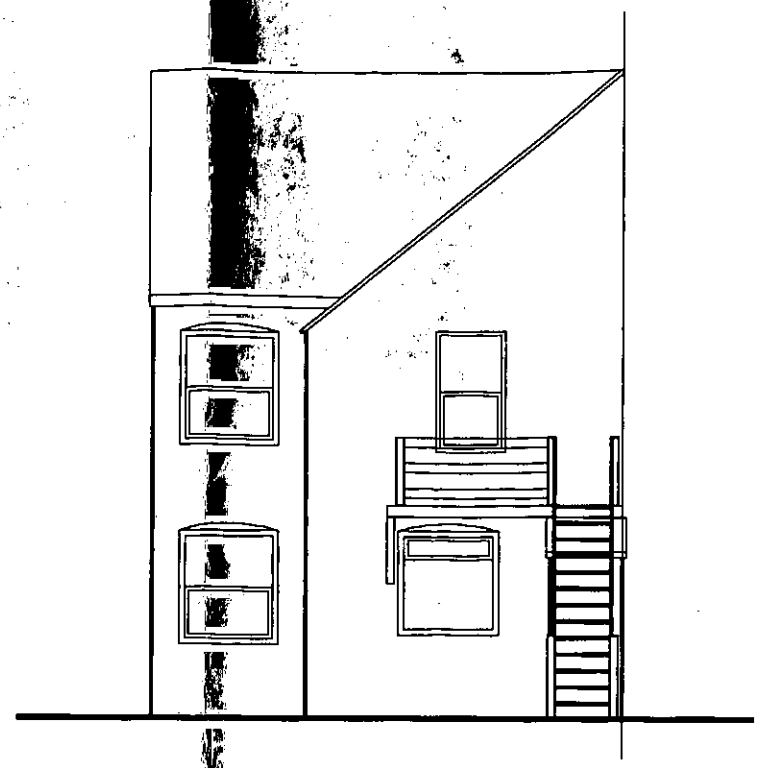

East Elevation

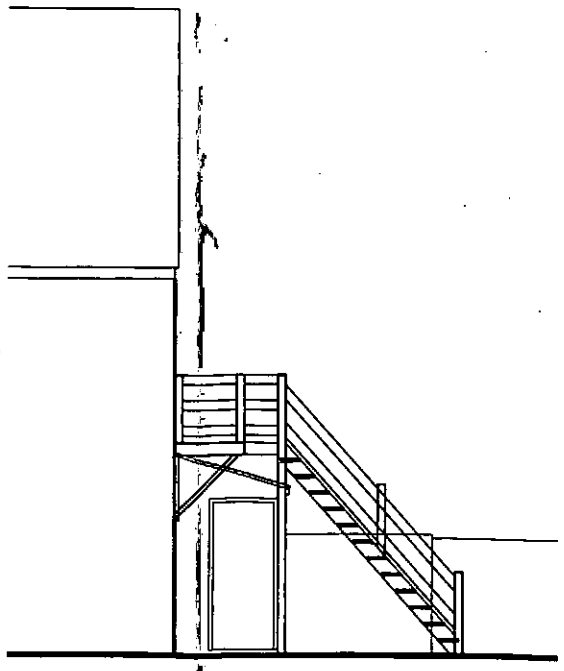

Part South Elevation

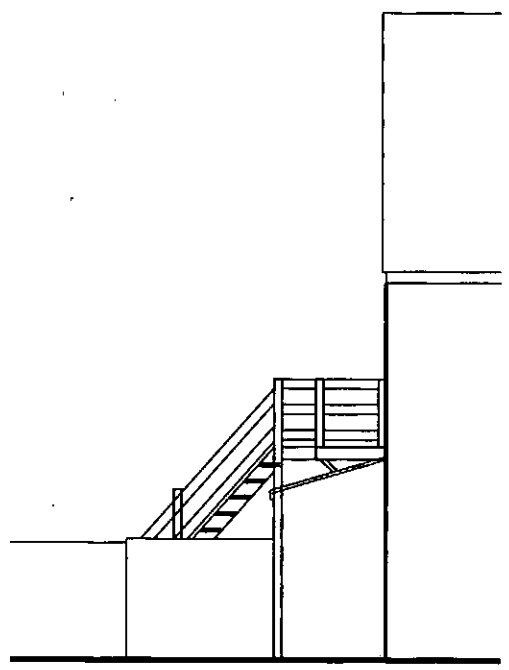

Part North Elevation

NOTES:

Dimensions to be checked on site before commencing work. Any discrepancies shall be reported to the architect immediately.

Do not scale from these drawings except for planning purposes.
Use figured dimensions only.

Where applicable this drawing is to be read in conjunction with other consultants' drawings.

This drawing is the copyright of hda projects ltd.

Rev	Date	Amendment

hda projects

6 The Old Flour Mill - Queen Street - Emsworth -
- Hampshire - PO10 7BT -

Tel: +44 (0) 1243 373855 Mob 07867978618
e-mail: hdaprojects@talktalk.net

For
Mr + Mrs Ellis

Project
14 Highfield Road
Bognor Regis
PO22 8BG

Title
Rear Emergency Escape
As Constructed

Date	Drawn	Scale	Checked
Dec 2010	wtm	1: 100 @ A3	

Job Number	Prefix	Drawing Number	Revision
1073	P	03	