

ARUN DISTRICT COUNCIL:FG/167/08

ARUN DISTRICT COUNCIL
No. FG 167 08

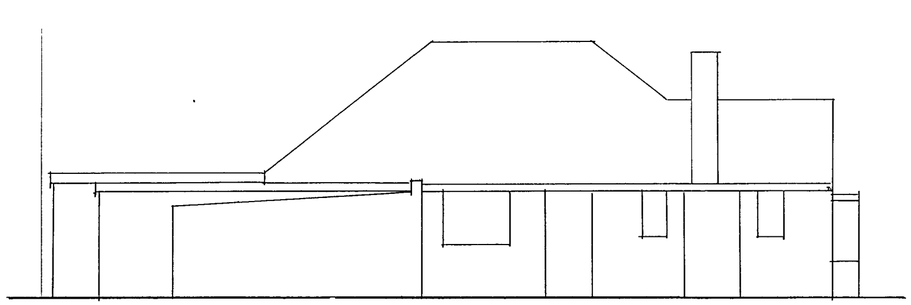


SIDE ELEVATION (E)

Scale 1:100

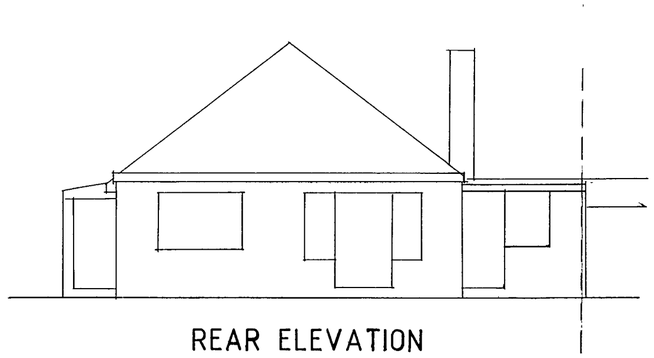


REAR ELEVATION

ABOVE ELEVATIONS AS APPROVAL FG/20/08

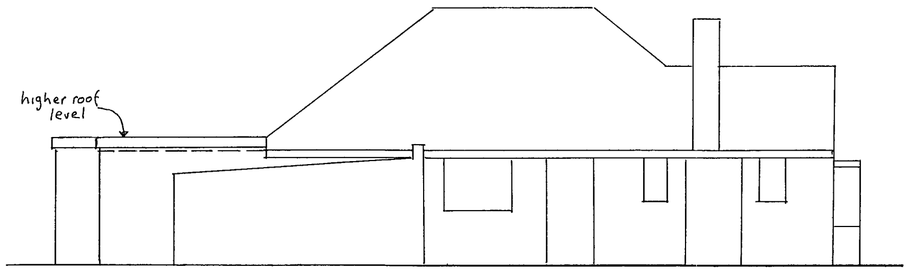


SIDE ELEVATION (E)

Scale 1:100

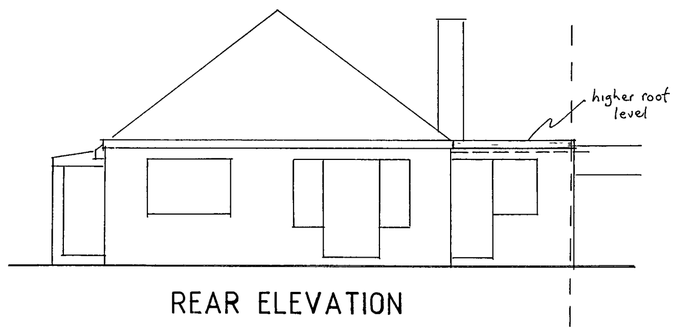

REAR ELEVATION

ELEVATIONS AS BUILT

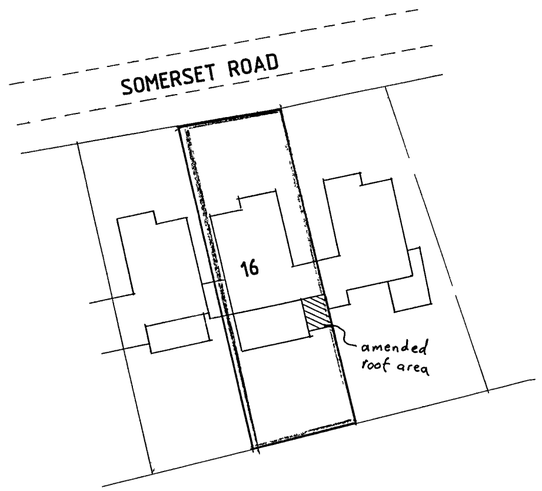

BLOCK PLAN Scale 1:500



LOCATION PLAN Scale 1:1250

RAISE LEVEL OF GARAGE ROOF AT SIDE

16 SOMERSET ROAD
FERRING