


STORM WATER DRAINAGE					
Manhole	Cover Level	Invert Level	Pipe Size	Gradient	Pipe Material
S54	5.2	2.76	600	-	PCC
S53	5.27	2.86	600	544	PCC
S52A	5.12	2.92	600	300	PCC
S52	4.92	3.22	375	75	PCC
S51	4.84	3.27	375	161	PCC
S50	4.76	3.46	300	67	PCC
S49	4.78	3.59	300	102	PCC
S48	4.98	3.83	300	89	PCC
S47	5.17	3.96	300	104	PCC
S46	5.22	4.11	225	104	VC
S46A	5.34	4.24	225	99	VC
S48	4.98	3.83	300	-	PCC
S48B	4.96	3.95	225	77	VC
S47	5.17	3.96	300	-	PCC
S44	5.46	4.14	300	200	PCC
S43	5.64	4.24	300	163	PCC
S42	5.9	4.55	225	85	VC
S41	6.14	4.74	225	123	VC
S40	6.23	4.93	225	112	VC
S54	5.2	2.8	600	-	PCC
S55	5.45	2.99	525	181	PCC
S57	5.68	3.34	375	101	PCC
S58	5.76	3.44	375	187	PCC
S59	5.65	3.73	225	63	VC
S58	5.76	3.52	375	-	PCC
S60	5.98	4.17	225	45	VC
S55	5.45	3.07	525	-	PCC
S63	5.12	3.31	375	159	PCC
S64	5.11	3.57	375	158	PCC
S65	5.29	3.69	375	191	PCC
S66	5.53	3.88	375	146	PCC
S67	5.76	4.03	375	175	PCC
S68	5.96	4.18	375	196	PCC
S69	6.1	4.33	300	105	PCC
S70	6.24	4.41	300	140	PCC
S71	6.38	4.61	225	90	VC
S72	6.62	4.77	225	144	VC
S73	6.84	5.53	225	32	VC
S65	5.29	3.69	225	-	VC
S65A	5.1	3.99	225	94	VC
S65B	5.01	4.1	225	123	VC

FOUL WATER DRAINAGE					
Manhole	Cover Level	Invert Level	Pipe Size	Gradient	Pipe Material
F131	5.19	3.01	150	-	VC
F132	5.00	3.29	150	158	VC
F146	5.00	3.35	150	150	VC
F145	5.25	3.56	150	151	VC
F144	5.64	3.85	150	157	VC
F142	5.74	3.96	150	159	VC
F141	5.72	4.12	150	117	VC
F140	5.49	4.45	150	77	VC
F142	5.74	3.95	150	-	VC
F143	6.06	4.25	150	116	VC
F157	6.03	4.52	150	195	VC
F156	6.07	4.75	150	161	VC
F155	6.17	4.94	150	150	VC
F154	6.37	4.99	150	149	VC
F153	6.63	5.29	150	73	VC
F132	5.00	3.29	150	-	VC
F147	5.26	3.37	150	143	VC
F148	5.42	3.51	150	153	VC
F149	5.59	3.66	150	107	VC
F150	5.93	3.86	150	152	VC
F151	6.09	4.02	150	142	VC
F161	5.04	1.86	150	-	VC
F160	5.10	2.03	150	154	VC
F159	5.31	2.17	150	155	VC
F158	5.51	3.57	150	21	VC
F159	5.31	2.17	150	-	VC
F133	5.08	2.38	150	126	VC

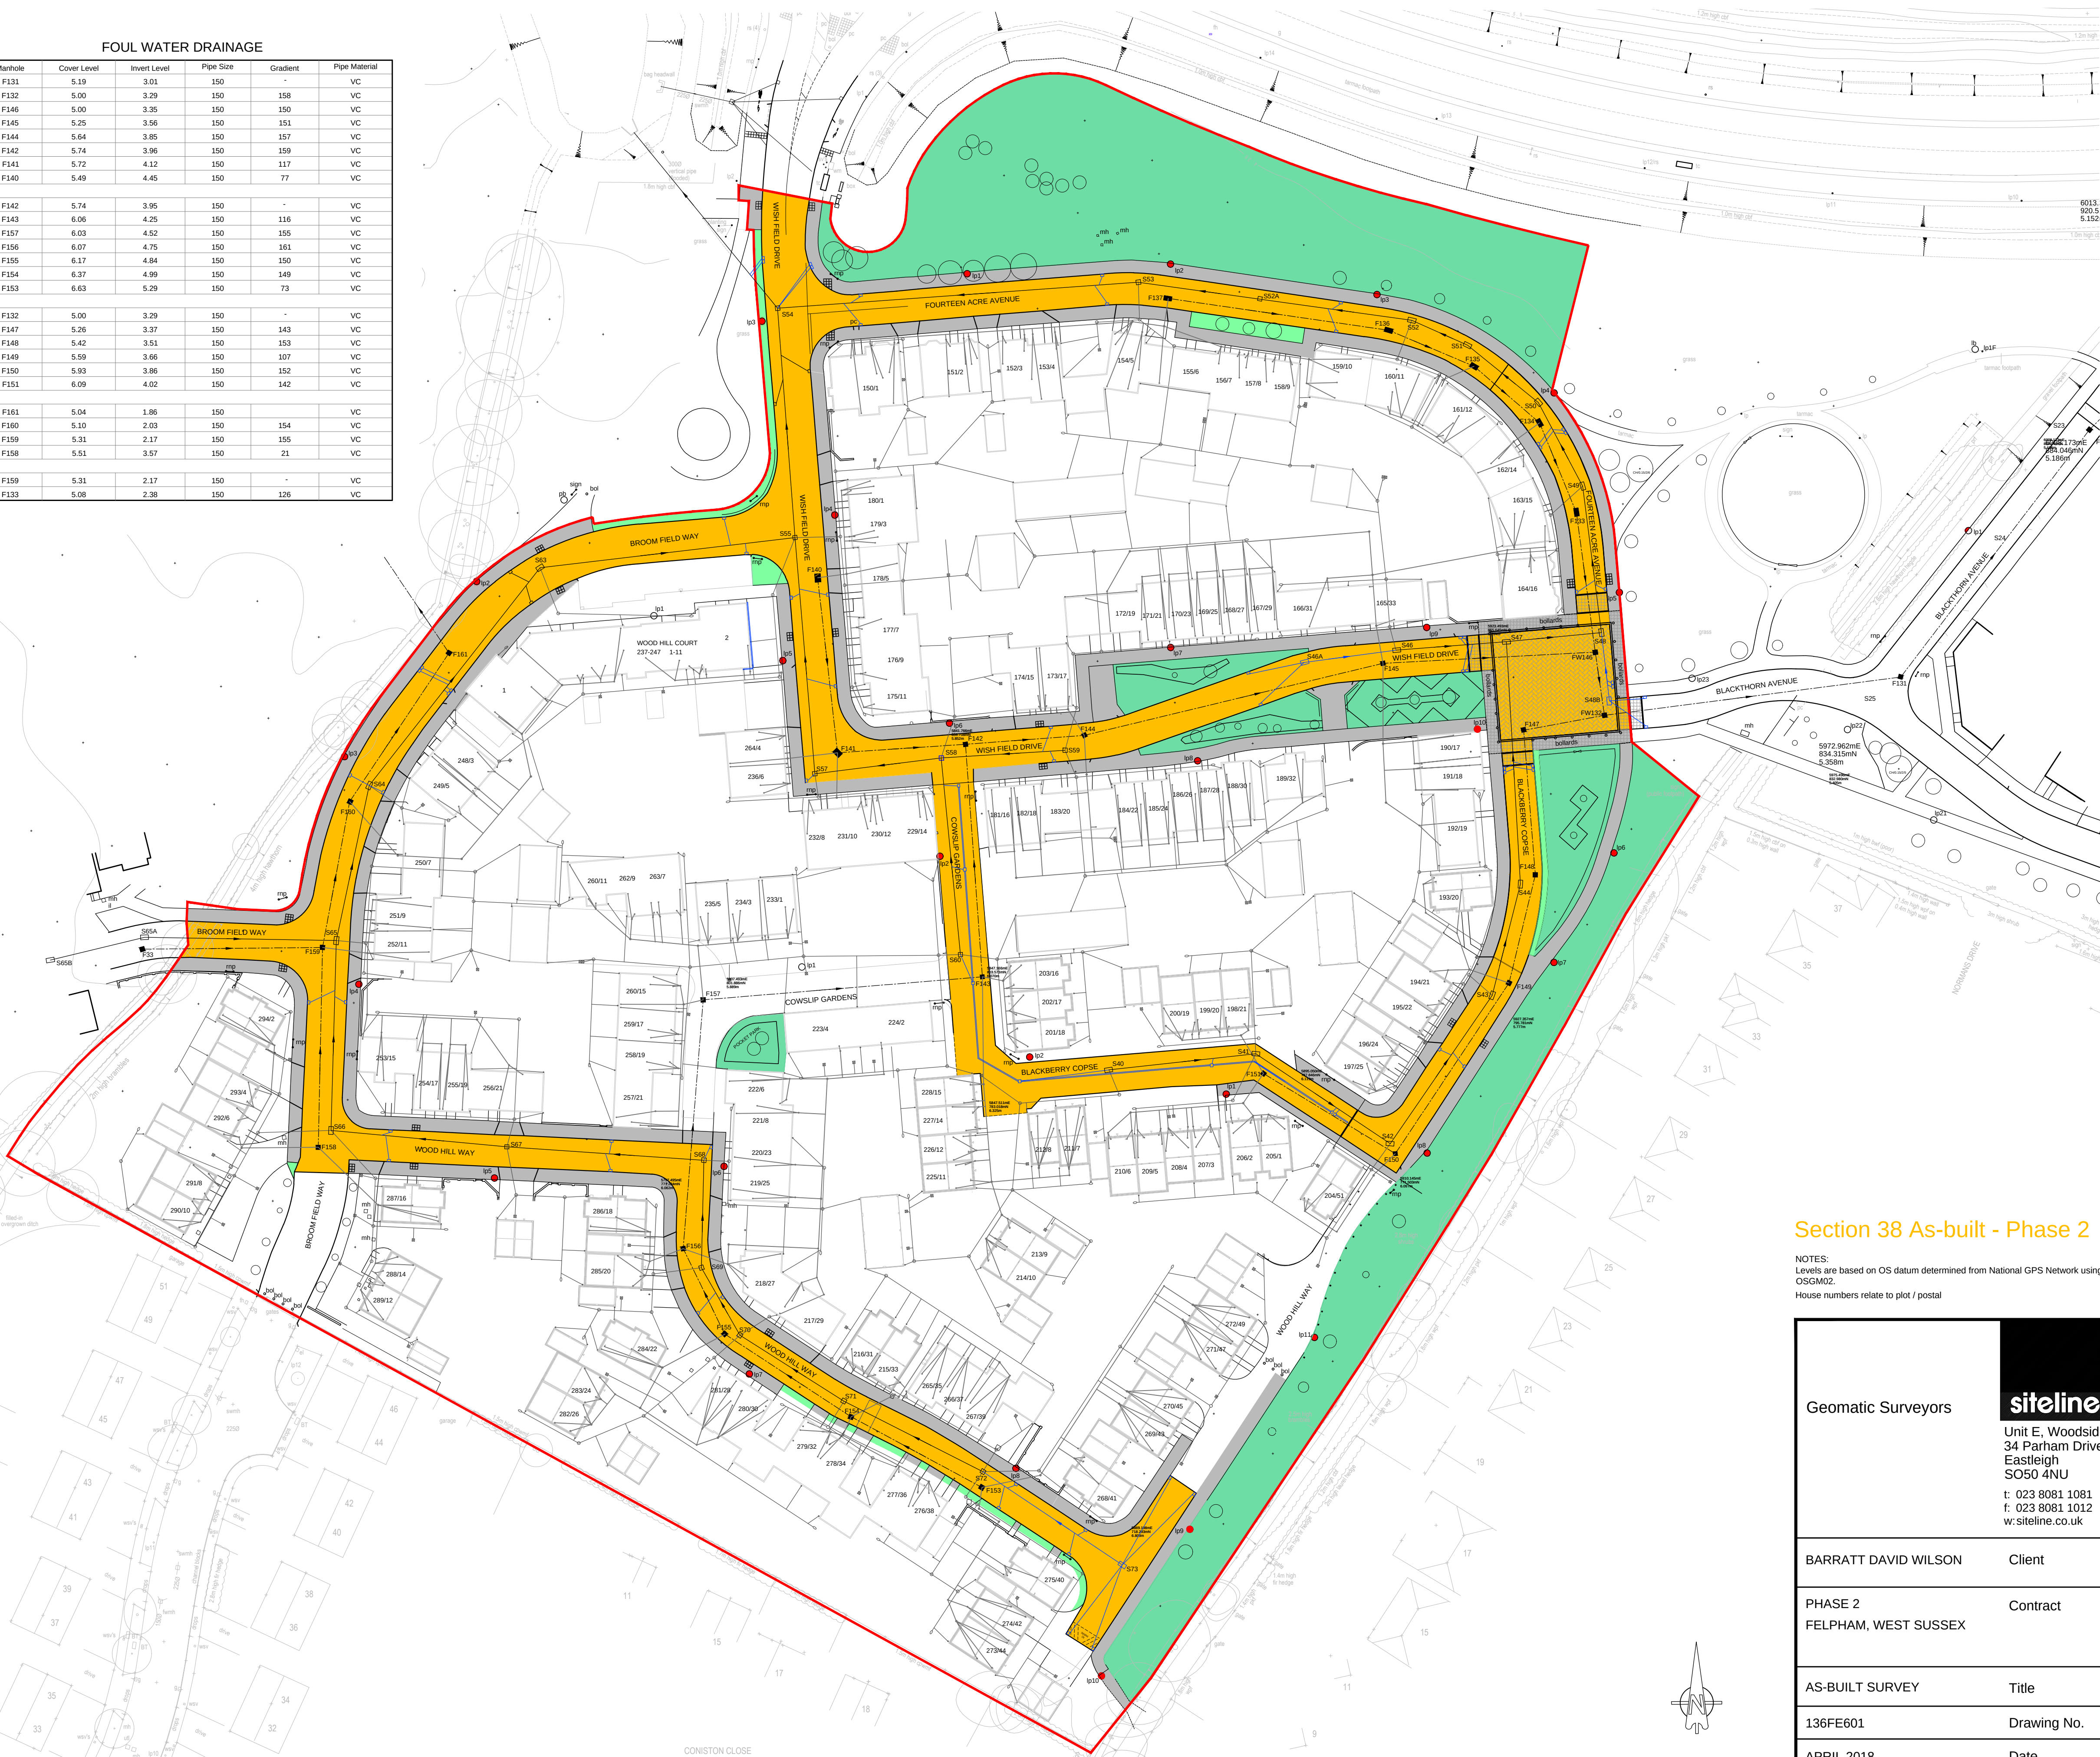

Section 38 As-built - Phase 2

NOTES:
Levels are based on OS datum determined from National GPS Network using OSGM02.
House numbers relate to plot / postal

Geomatic Surveyors		siteline	
		Unit E, Woodside 34 Parham Drive Eastleigh SO50 4NU t: 023 8081 1081 f: 023 8081 1012 w: siteline.co.uk	
BARRATT DAVID WILSON		Client	
PHASE 2 FELPHAM, WEST SUSSEX		Contract	
AS-BUILT SURVEY		Title	
136FE601		Drawing No.	
APRIL 2018		Date	
1:500 (A1)		Scale	
SB/RS		Surveyor	