FOR DETAILED PLANTING DESIGN REFER TO FABRIK SHEET L.700

FOR PHASE 1 AND 2 DETAILED PLANTING DESIGN REFER TO FABRIK SHEET L.300-L.306

AFFORDABLE HOUSING AREA- NO DETAILED PLANTING SHOWN

REFER TO INSET FABRIK SHEET L.312

REFER TO FABRIK SHEET L.313

PHASE 4

PHASE 5

Notes
1. This drawing is the property of fabrik ltd. It must not be copied or reproduced without written consent.
2. Only figured dimensions are to be taken from this drawing. All contractors must visit site and be responsible for taking and checking all dimensions related to the works shown on the drawing.

LEGEND


Soft Landscape

- Existing Tree
- Existing Vegetaion
- Proposed Tree Planting
- Proposed Specimen Shrub Planting
- Proposed Hedge Planting
- Proposed Native Mix Planting
- Proposed Shrub Planting
- GT1- Proposed Amenity Grass
- GT2- Proposed Meadow Grass
- Proposed Bulb Planting

Other

- Phase Boundary
- Private Garden

Keyplan

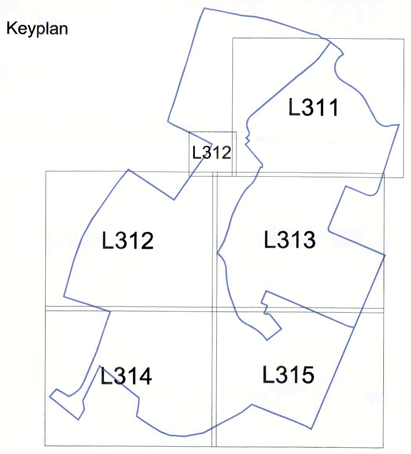

No. Date Reason Name
Revisions
External References:
- D1530 Felpham, Bognor Regis\Drawings\Architect\Recvd-14-03-17\PLAN-LAY_PH4-5_140317\SITE LAYOUT PH 4 5 REPLAN_1

fabrik
38a High Street
Alton
Hampshire
GU34 1BD

T : 01420 593250
F : 01420 544243
E : alton@fabrikuk.com
W : www.fabrikuk.com

Project
Felpham, Bognor Regis
for Barratt Homes

Drawing
Detailed Planting Plan Sheet 1 of 5

Scale	Date	Drawn
1:200 @ A0	March '14	pc

Drawing No. D1530 L.311

Revision -

- [] Preliminary
- [] Issued for Planning Approval
- [] Issued for Construction
- [] Issued for Design/Information
- [] Issued for Tender
- [x] As Built

Drawing sheet size - A0

Copyright Reserved ©

m 0 2 4 6 8 10 12 14 16 18 20
Scale 1:200

north