REFER TO FABRIK SHEET L.311

REFER TO FABRIK SHEET L.312

REFER TO FABRIK SHEET L.315

AFFORDABLE HOUSING AREA- NO DETAILED PLANTING SHOWN

AFFORDABLE HOUSING AREA- NO DETAILED PLANTING SHOWN

AFFORDABLE HOUSING AREA- NO DETAILED PLANTING SHOWN

FOR SPORTS AREA DETAILED PLANTING DESIGN REFER TO FABRIK SHEET L.500

PHASE 5

PHASE 4

PHASE 3

PHASE 2

PHASE 1

450no. Crocus (mixed)
450no. Camassia leichtlinii

450no. Galanthus nivalis
450no. Hyacinthoides non-scripta

11 Skimmia japonica
6 Hebe 'White Gem'
12 Aucuba japonica 'Salicifolia'
8 Lavandula 'Vera'
10 Rosmarianus 'Miss Jessops Upright'
8 Cistus 'Silver Pink'
8 Hebe 'Marjorie'
8 Philadelphus 'Manteau d'Hermine'
16 Sarcococca hookeriana

5 Rosmarianus 'Miss Jessops Upright'
6 Cistus 'Silver Pink'
6 Skimmia japonica
6 Berberis atropurpurea 'Nana'

19 Sarcococca hookeriana
13 Rosmarianus 'Miss Jessops Upright'
7 Cistus 'Silver Pink'
8 Aucuba japonica 'Salicifolia'
16 Sarcococca hookeriana
8 Lavandula 'Vera'
25 Deutzia x elegantissima
11 Rosmarinus 'Miss Jessops Upright'
13 Skimmia japonica
4 Sarcococca hookeriana
8 Cistus 'Silver Pink'
10 Skimmia japonica

13 Sarcococca hookeriana
17 Escallonia 'Apple Blossom'
21 Hebe 'Marjorie'
27 Lavandula 'Vera'

14 Sarcococca hookeriana
8 Hebe 'White Gem'
11 Cistus 'Silver Pink'
10 Rosmarianus 'Miss Jessops Upright'
9 Lavandula 'Vera'
8 Skimmia japonica

9 Viburnum davidii
9 Osmanthus x Burkwoodii
14 Sarcococca hookeriana
9 Skimmia japonica
13 Hebe 'Marjorie'
9 Rosmarianus 'Miss Jessops Upright'
10 Hebe 'White Gem'
10 Cistus 'Silver Pink'
9 Rosmarianus 'Miss Jessops Upright'

350no. Galanthus nivalis
350no. Hyacinthoides non-scripta

600no. Crocus (mixed)
600no. Camassia leichtlinii

300no. Galanthus nivalis
300no. Hyacinthoides non-scripta

300no. Crocus (mixed)
300no. Camassia leichtlinii

18 Cistus 'Silver Pink'
6 Berberis atropurpurea 'Nana'
15 Rosmarianus 'Miss Jessops Upright'
5 Deutzia x elegantissima
15 Sarcococca hookeriana
8 Osmanthus x Burkwoodii
8 Lavandula 'Vera'
11 Lavandula 'Vera'

19 Viburnum davidii
8 Aucuba japonica 'Salicifolia'
6 Sarcococca hookeriana
19 Philadelphus 'Manteau d'Hermine'

15 Deutzia x elegantissima

23 Rosmarianus 'Miss Jessops Upright'
19 Skimmia japonica
13 Lavandula 'Vera'

300no. Galanthus nivalis
300no. Hyacinthoides non-scripta

300no. Galanthus nivalis
300no. Hyacinthoides non-scripta

17 Lavandula 'Vera'
20 Aucuba japonica 'Salicifolia'
16 Spiraea japonica 'Little Princess'
7 Lavandula 'Vera'

300no. Crocus (mixed)
300no. Camassia leichtlinii

23 Cistus 'Silver Pink'
11 Spiraea japonica 'Little Princess'
8 Osmanthus x Burkwoodii
14 Rosmarianus 'Miss Jessops Upright'
11 Skimmia japonica
16 Lavandula 'Vera'
18 Viburnum tinus
21 Osmanthus x Burkwoodii
13 Philadelphus 'Manteau d'Hermine'

300no. Crocus (mixed)
300no. Camassia leichtlinii

300no. Crocus (mixed)
300no. Camassia leichtlinii

300no. Galanthus nivalis
300no. Hyacinthoides non-scripta

400no. Galanthus nivalis
400no. Hyacinthoides non-scripta

125no. Crocus (mixed)
125no. Camassia leichtlinii

125no. Crocus (mixed)
125no. Camassia leichtlinii

200no. Crocus (mixed)
200no. Camassia leichtlinii

200no. Galanthus nivalis
200no. Hyacinthoides non-scripta

200no. Crocus (mixed)
200no. Camassia leichtlinii

6 Skimmia japonica
15 Cistus 'Silver Pink'
9 Lavandula 'Vera'
30 Viburnum davidii
15 Viburnum davidii
10 Skimmia japonica
6 Viburnum davidii
7 Sarcococca hookeriana
10 Viburnum davidii

12 Lavandula 'Vera'
5 Sarcococca hookeriana

6 Rosmarianus 'Miss Jessops Upright'
11 Hebe 'White Gem'

19 Spiraea japonica 'Little Princess'
8 Skimmia japonica
8 Rosmarianus 'Miss Jessops Upright'
8 Lavandula 'Vera'
9 Cistus 'Silver Pink'
6 Hebe 'White Gem'
6 Skimmia japonica
8 Cistus 'Silver Pink'
6 Deutzia x elegantissima
8 Lavandula 'Vera'
15 Sarcococca hookeriana
16 Philadelphus 'Manteau d'Hermine'
16 Spiraea japonica 'Little Princess'
14 Hebe 'Marjorie'

500no. Galanthus nivalis
500no. Hyacinthoides non-scripta

150no. Crocus (mixed)
150no. Camassia leichtlinii

16 Hebe 'White Gem'
9 Skimmia japonica
15 Viburnum davidii
5 Rosmarianus 'Miss Jessops Upright'
8 Hebe 'White Gem'
13 Hebe 'Marjorie'
5 Lavandula 'Vera'

300no. Galanthus nivalis
300no. Hyacinthoides non-scripta

8 Lavandula 'Vera'
7 Hebe 'Marjorie'
9 Cistus 'Silver Pink'
4 Philadelphus 'Manteau d'Hermine'
9 Hebe 'Marjorie'
8 Hebe 'White Gem'
4 Deutzia x elegantissima

6 Rosmarianus 'Miss Jessops Upright'
5 Lavandula 'Vera'
14 Hebe 'Marjorie'
5 Lavandula 'Vera'
6 Rosmarianus 'Miss Jessops Upright'

300no. Galanthus nivalis
300no. Hyacinthoides non-scripta

300no. Galanthus nivalis
300no. Hyacinthoides non-scripta

300no. Crocus (mixed)
300no. Camassia leichtlinii

375no. Crocus (mixed)
375no. Camassia leichtlinii

375no. Galanthus nivalis
375no. Hyacinthoides non-scripta

300no. Galanthus nivalis
300no. Hyacinthoides non-scripta

300no. Galanthus nivalis
300no. Hyacinthoides non-scripta

6 Sarcococca hookeriana
7 Cistus 'Silver Pink'
7 Hebe 'Marjorie'
8 Aucuba japonica 'Salicifolia'
8 Rosmarianus 'Miss Jessops Upright'
6 Sarcococca hookeriana
7 Cistus 'Silver Pink'
8 Aucuba japonica 'Salicifolia'
8 Rosmarianus 'Miss Jessops Upright'
5 Hebe 'White Gem'
8 Skimmia japonica
8 Cistus 'Silver Pink'

300no. Galanthus nivalis
300no. Hyacinthoides non-scripta

300no. Crocus (mixed)
300no. Camassia leichtlinii

200no. Crocus (mixed)
200no. Camassia leichtlinii

25 Hebe 'White Gem'
20 Skimmia japonica
11 Abelia grandiflora

16 Hebe 'White Gem'
9 Skimmia japonica
15 Viburnum davidii
5 Rosmarianus 'Miss Jessops Upright'
8 Hebe 'White Gem'
13 Hebe 'Marjorie'
5 Lavandula 'Vera'

300no. Galanthus nivalis
300no. Hyacinthoides non-scripta

8 Lavandula 'Vera'
7 Hebe 'Marjorie'
9 Cistus 'Silver Pink'
4 Philadelphus 'Manteau d'Hermine'
9 Hebe 'Marjorie'
8 Hebe 'White Gem'
4 Deutzia x elegantissima

6 Rosmarianus 'Miss Jessops Upright'
5 Lavandula 'Vera'
14 Hebe 'Marjorie'
5 Lavandula 'Vera'
6 Rosmarianus 'Miss Jessops Upright'

5 Hebe 'White Gem'
5 Hebe 'White Gem'
15 Lonicera pileata 'Lowgrail Evergreen'
12 Cornus alba 'Sibirica'
10 Lonicera pileata 'Lowgrail Evergreen'

7 Lavandula 'Vera'
2 Lavandula 'Vera'
15 Lonicera pileata 'Lowgrail Evergreen'
12 Cornus alba 'Sibirica'
10 Lonicera pileata 'Lowgrail Evergreen'

5 Hebe 'White Gem'
5 Hebe 'White Gem'
15 Lonicera pileata 'Lowgrail Evergreen'
11 Cornus alba 'Sibirica'
10 Lonicera pileata 'Lowgrail Evergreen'

3 Lavandula 'Vera'
7 Lavandula 'Vera'

7 Lavandula 'Vera'

5 Aucuba japonica 'Salicifolia'
5 Sarcococca hookeriana
4 Sarcococca hookeriana
4 Skimmia japonica
4 Viburnum davidii

1150no. Crocus (mixed)
1150no. Camassia leichtlinii

12 Sarcococca hookeriana
4 Osmanthus x Burkwoodii
4 Viburnum davidii
4 Skimmia japonica
10 Philadelphus 'Manteau d'Hermine'
5 Rosmarianus 'Miss Jessops Upright'
7 Cistus 'Silver Pink'
6 Skimmia japonica
5 Sarcococca hookeriana
3 Lavandula 'Vera'

300no. Crocus (mixed)
300no. Camassia leichtlinii

200no. Crocus (mixed)
200no. Camassia leichtlinii

300no. Crocus (mixed)
300no. Camassia leichtlinii

250no. Galanthus nivalis
250no. Hyacinthoides non-scripta

8 Hebe 'Marjorie'
4 Rosmarianus 'Miss Jessops Upright'
250no. Galanthus nivalis
250no. Hyacinthoides non-scripta
5 Cistus 'Silver Pink'
5 Skimmia japonica
6 Sarcococca hookeriana
4 Hebe 'Marjorie'

4 Rosmarianus 'Miss Jessops Upright'
5 Skimmia japonica
250no. Galanthus nivalis
250no. Hyacinthoides non-scripta
8 Sarcococca hookeriana
9 Osmanthus x Burkwoodii
10 Viburnum davidii
6 Lavandula 'Vera'
8 Rosmarianus 'Miss Jessops Upright'
6 Skimmia japonica
250no. Galanthus nivalis
250no. Hyacinthoides non-scripta
9 Viburnum davidii
6 Osmanthus x Burkwoodii
5 Sarcococca hookeriana
5 Lavandula 'Vera'

9 Hebe 'Marjorie'
15 Philadelphus 'Manteau d'Hermine'
14 Lavandula 'Vera'

6 Viburnum davidii
8 Skimmia japonica
4 Sarcococca hookeriana
4 Sarcococca hookeriana
5 Osmanthus x Burkwoodii
14 Sarcococca hookeriana
11 Hebe 'Marjorie'
9 Cistus 'Silver Pink'
6 Philadelphus 'Manteau d'Hermine'

450no. Galanthus nivalis
450no. Hyacinthoides non-scripta

475no. Galanthus nivalis
475no. Hyacinthoides non-scripta

north

Scale m 0 2 4 6 8 10 12 14 16 18 20
1:200

Notes
1. This drawing is the property of fabrik ltd. It must not be copied or reproduced without written consent.
2. Only figured dimensions are to be taken from this drawing. All contractors must visit site and be responsible for taking and checking all dimensions related to the works shown on the drawing.

LEGEND


Soft Landscape

- Existing Tree
- Existing Vegetaion
- Proposed Tree Planting
- Proposed Specimen Shrub Planting
- Proposed Hedge Planting
- Proposed Native Mix Planting
- Proposed Shrub Planting
- GT1- Proposed Amenity Grass
- GT2- Proposed Meadow Grass
- Proposed Bulb Planting

Other

- Phase Boundary
- Private Garden

Keyplan

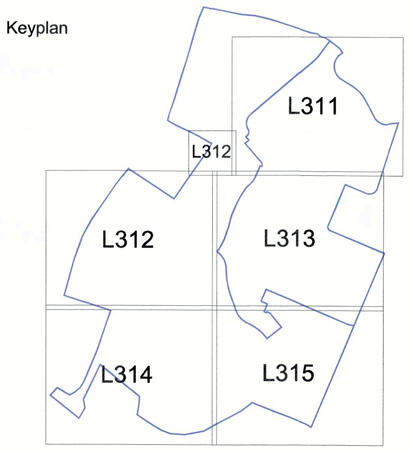

No.	Date	Reason	Name
Revisions			

External References:
- D1530 Felpham, Bognor Regis\Drawings\Architect\Revit-14-03-17\PLAN-LAY_PH4-5_140317\SITE LAYOUT PH 4 5 REPLAN_1

fabrik
38a High Street
Alton
Hamphire
GU34 1BD

T : 01420 593250
F : 01420 544243
E : alton@fabrikuk.com
W : www.fabrikuk.com

Project
Felpham, Bognor Regis
for Barratt Homes

Drawing
Detailed Planting Plan Sheet 3 of 5

Scale	Date	Drawn
1:200 @ A0	March '14	pc

Drawing No. D1530 L.313

Revision -

- [] Preliminary
- [] Issued for Planning Approval
- [] Issued for Construction
- [] Issued for Design/Information
- [] Issued for Tender
- [x] As Built

Drawing sheet size - A0

Copyright Reserved ©