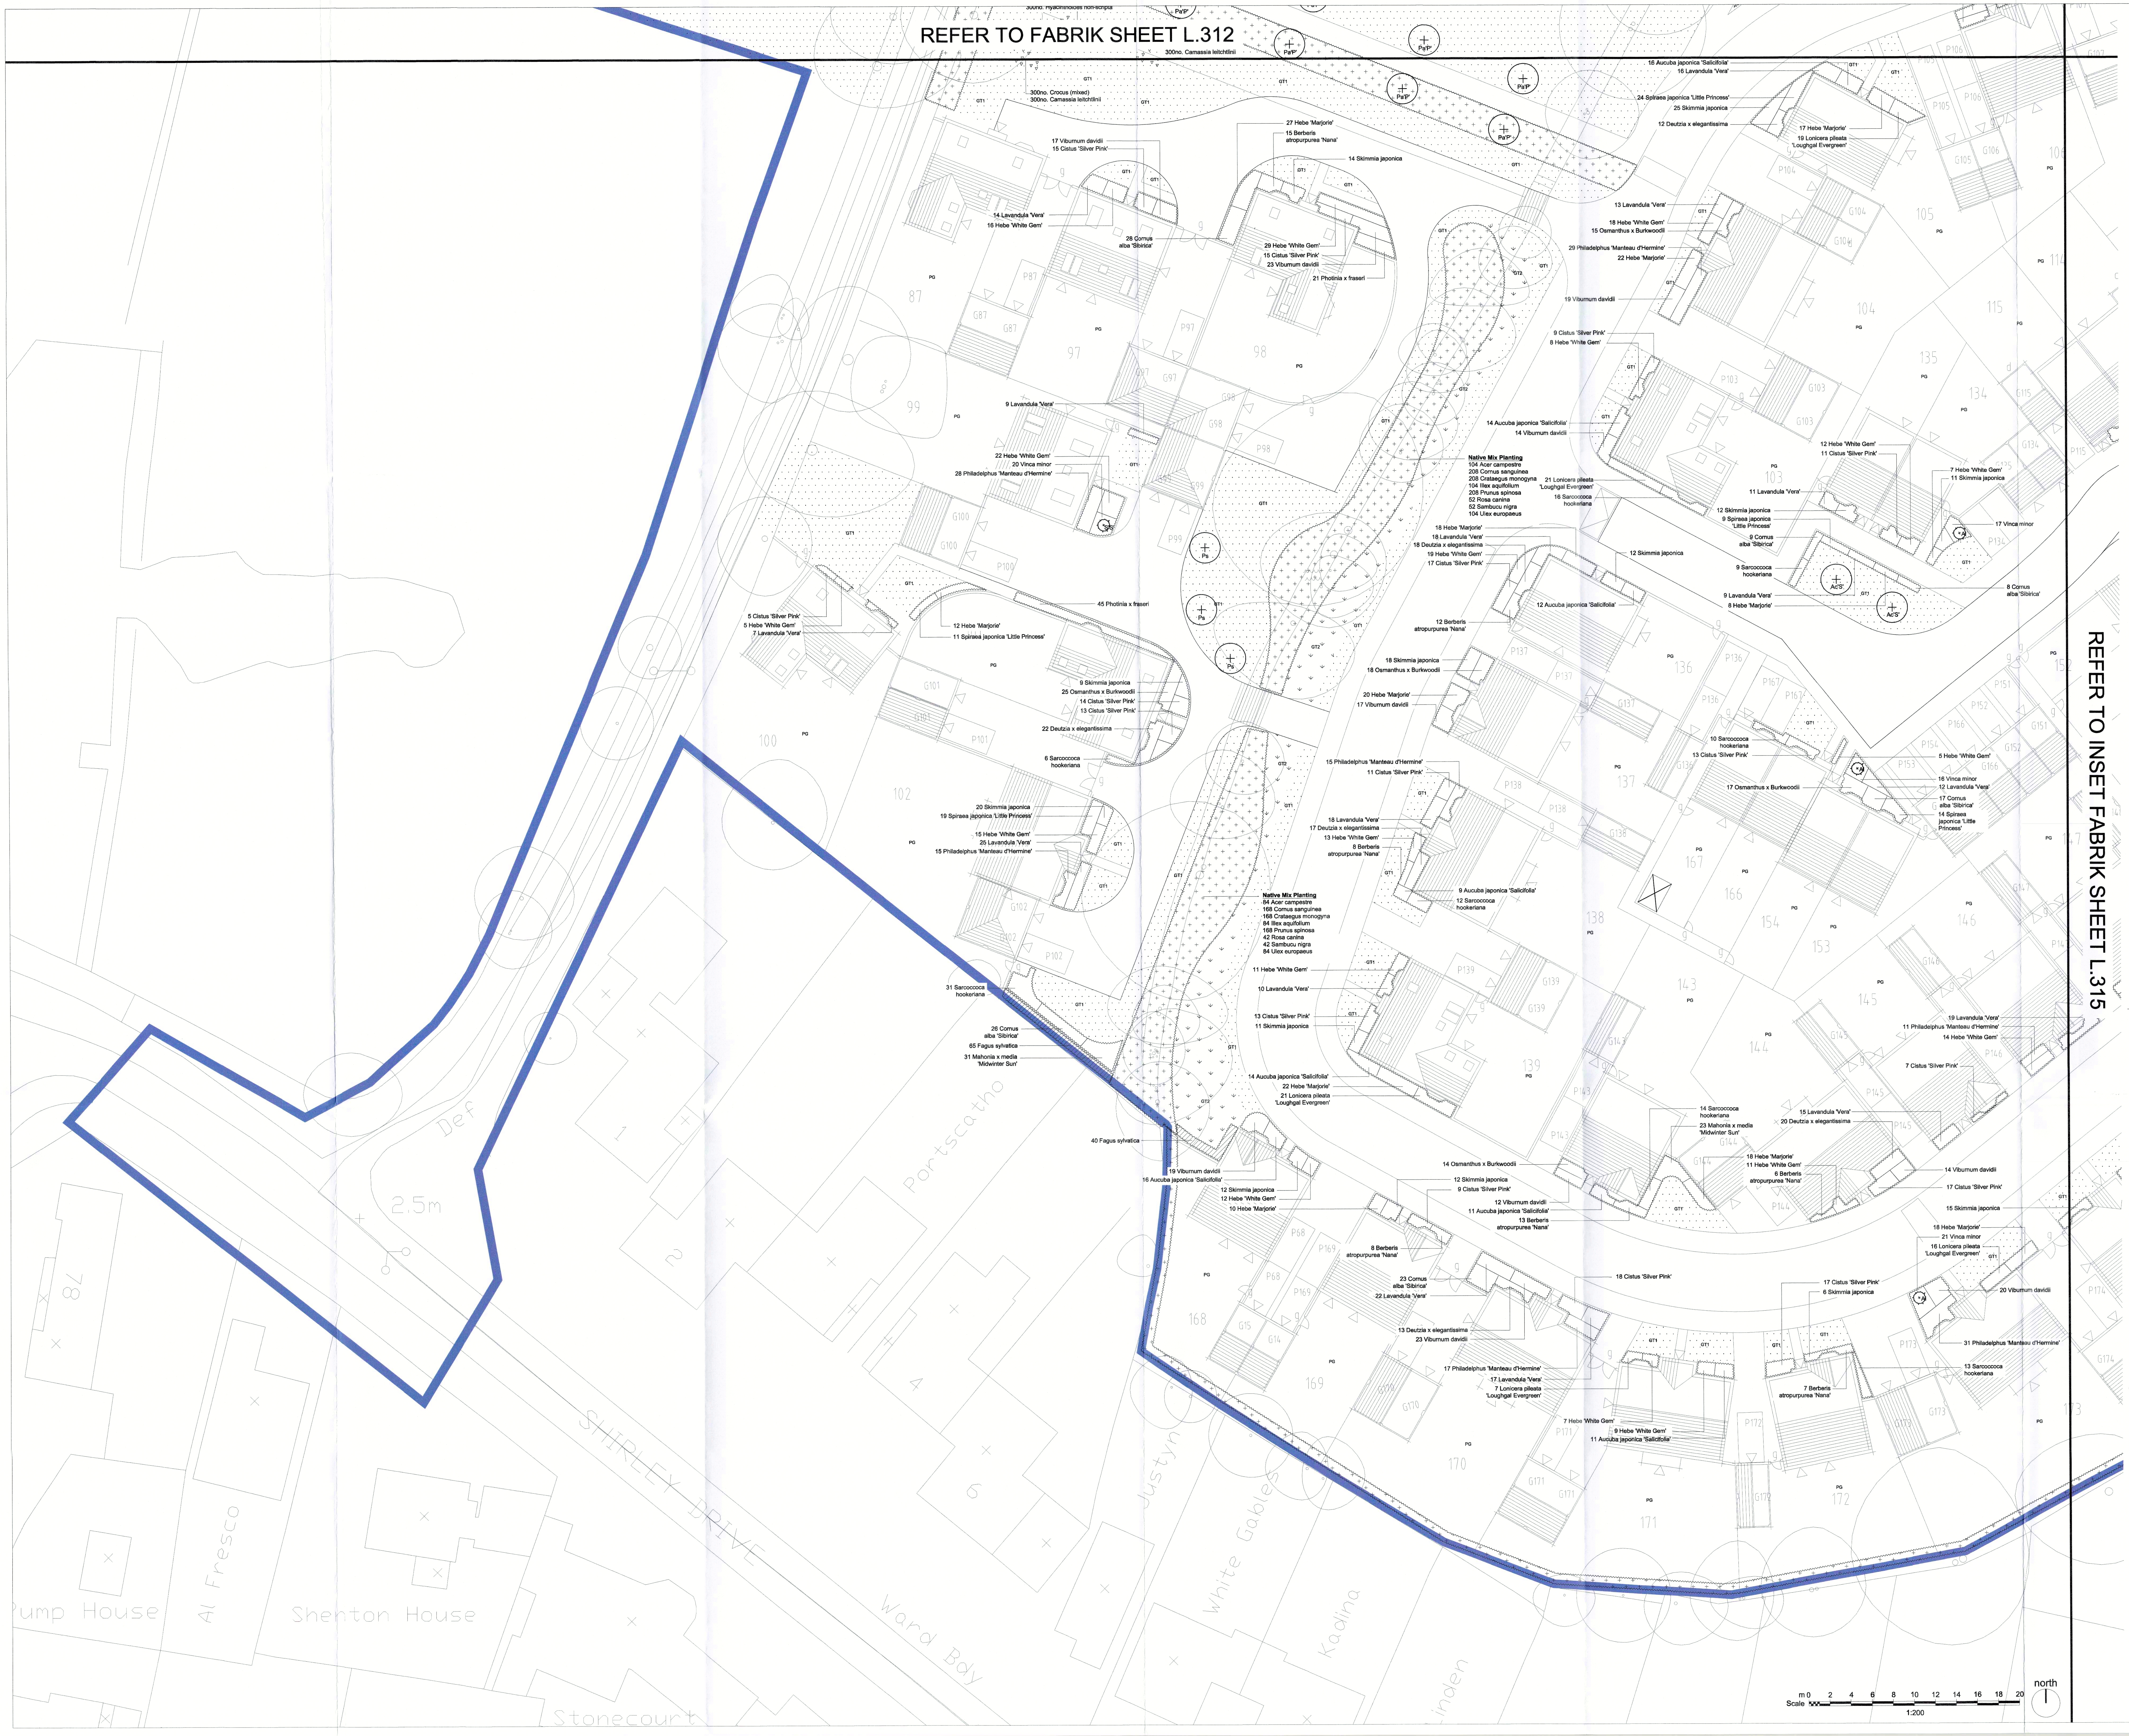

Notes
1. This drawing is the property of fabrik ltd. It must not be copied or reproduced without written consent.
2. Only figured dimensions are to be taken from this drawing. All contractors must visit site and be responsible for taking and checking all dimensions related to the works shown on the drawing.

LEGEND

Soft Landscape

☐	Existing Tree
☐	Existing Vegetaion
⊕	Proposed Tree Planting
⊙	Proposed Specimen Shrub Planting
▨	Proposed Hedge Planting
+	Proposed Native Mix Planting
☐	Proposed Shrub Planting
GT1	GT1- Proposed Amenity Grass
GT2	GT2- Proposed Meadow Grass
▽	Proposed Bulb Planting

Other

▬	Phase Boundary
PG	Private Garden

Keyplan

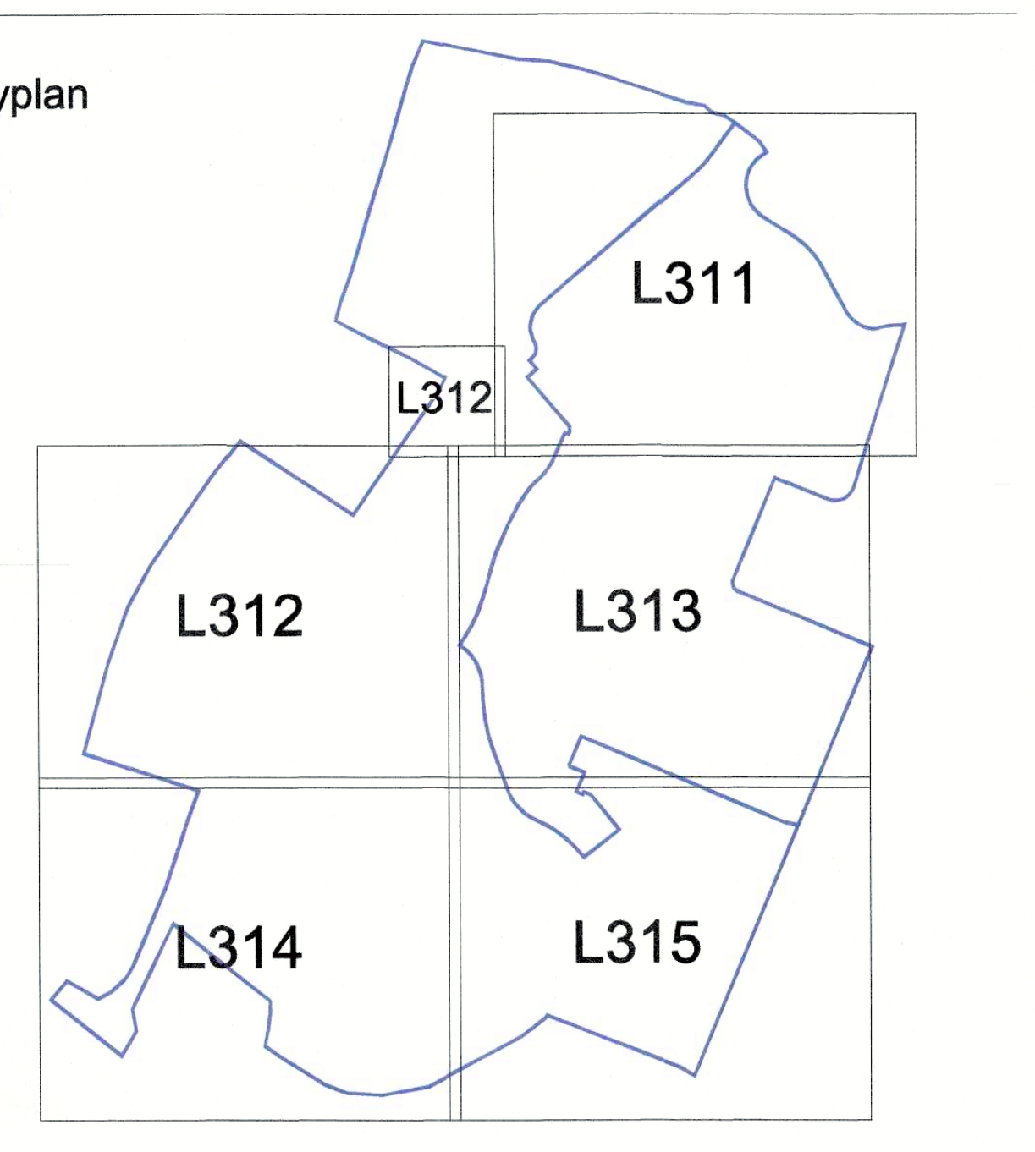

No.	Date	Reason	Name
A	01.05.14	Drawing updated following plot renumbering	th

Revisions

External References:
- D1530 Felpham, Bognor Regis\Drawings\Architect\Recvd-14-03-17\PLAN-LAY_PH4-5_140317\SITE LAYOUT PH 4 5 REPLAN_1

fabrik
38a High Street
Alton
Hamphire
GU34 1BD

T : 01420 593250
F : 01420 544243
E : alton@fabrikuk.com
W : www.fabrikuk.com

Project
Felpham, Bognor Regis
for Barratt Homes

Drawing
Detailed Planting Plan Sheet 4 of 5

Scale: 1:200 @ A0
Date: March '14
Drawn: pc
Drawing No.: D1530 L.314
Revision: A

☐ Preliminary
☐ Issued for Planning Approval
☐ Issued for Construction
☐ Issued for Design/Information
☐ Issued for Tender
■ As Built

Drawing sheet size - A0

Copyright Reserved ©

ARUN DISTRICT COUNCIL FP/84/19/DOC