



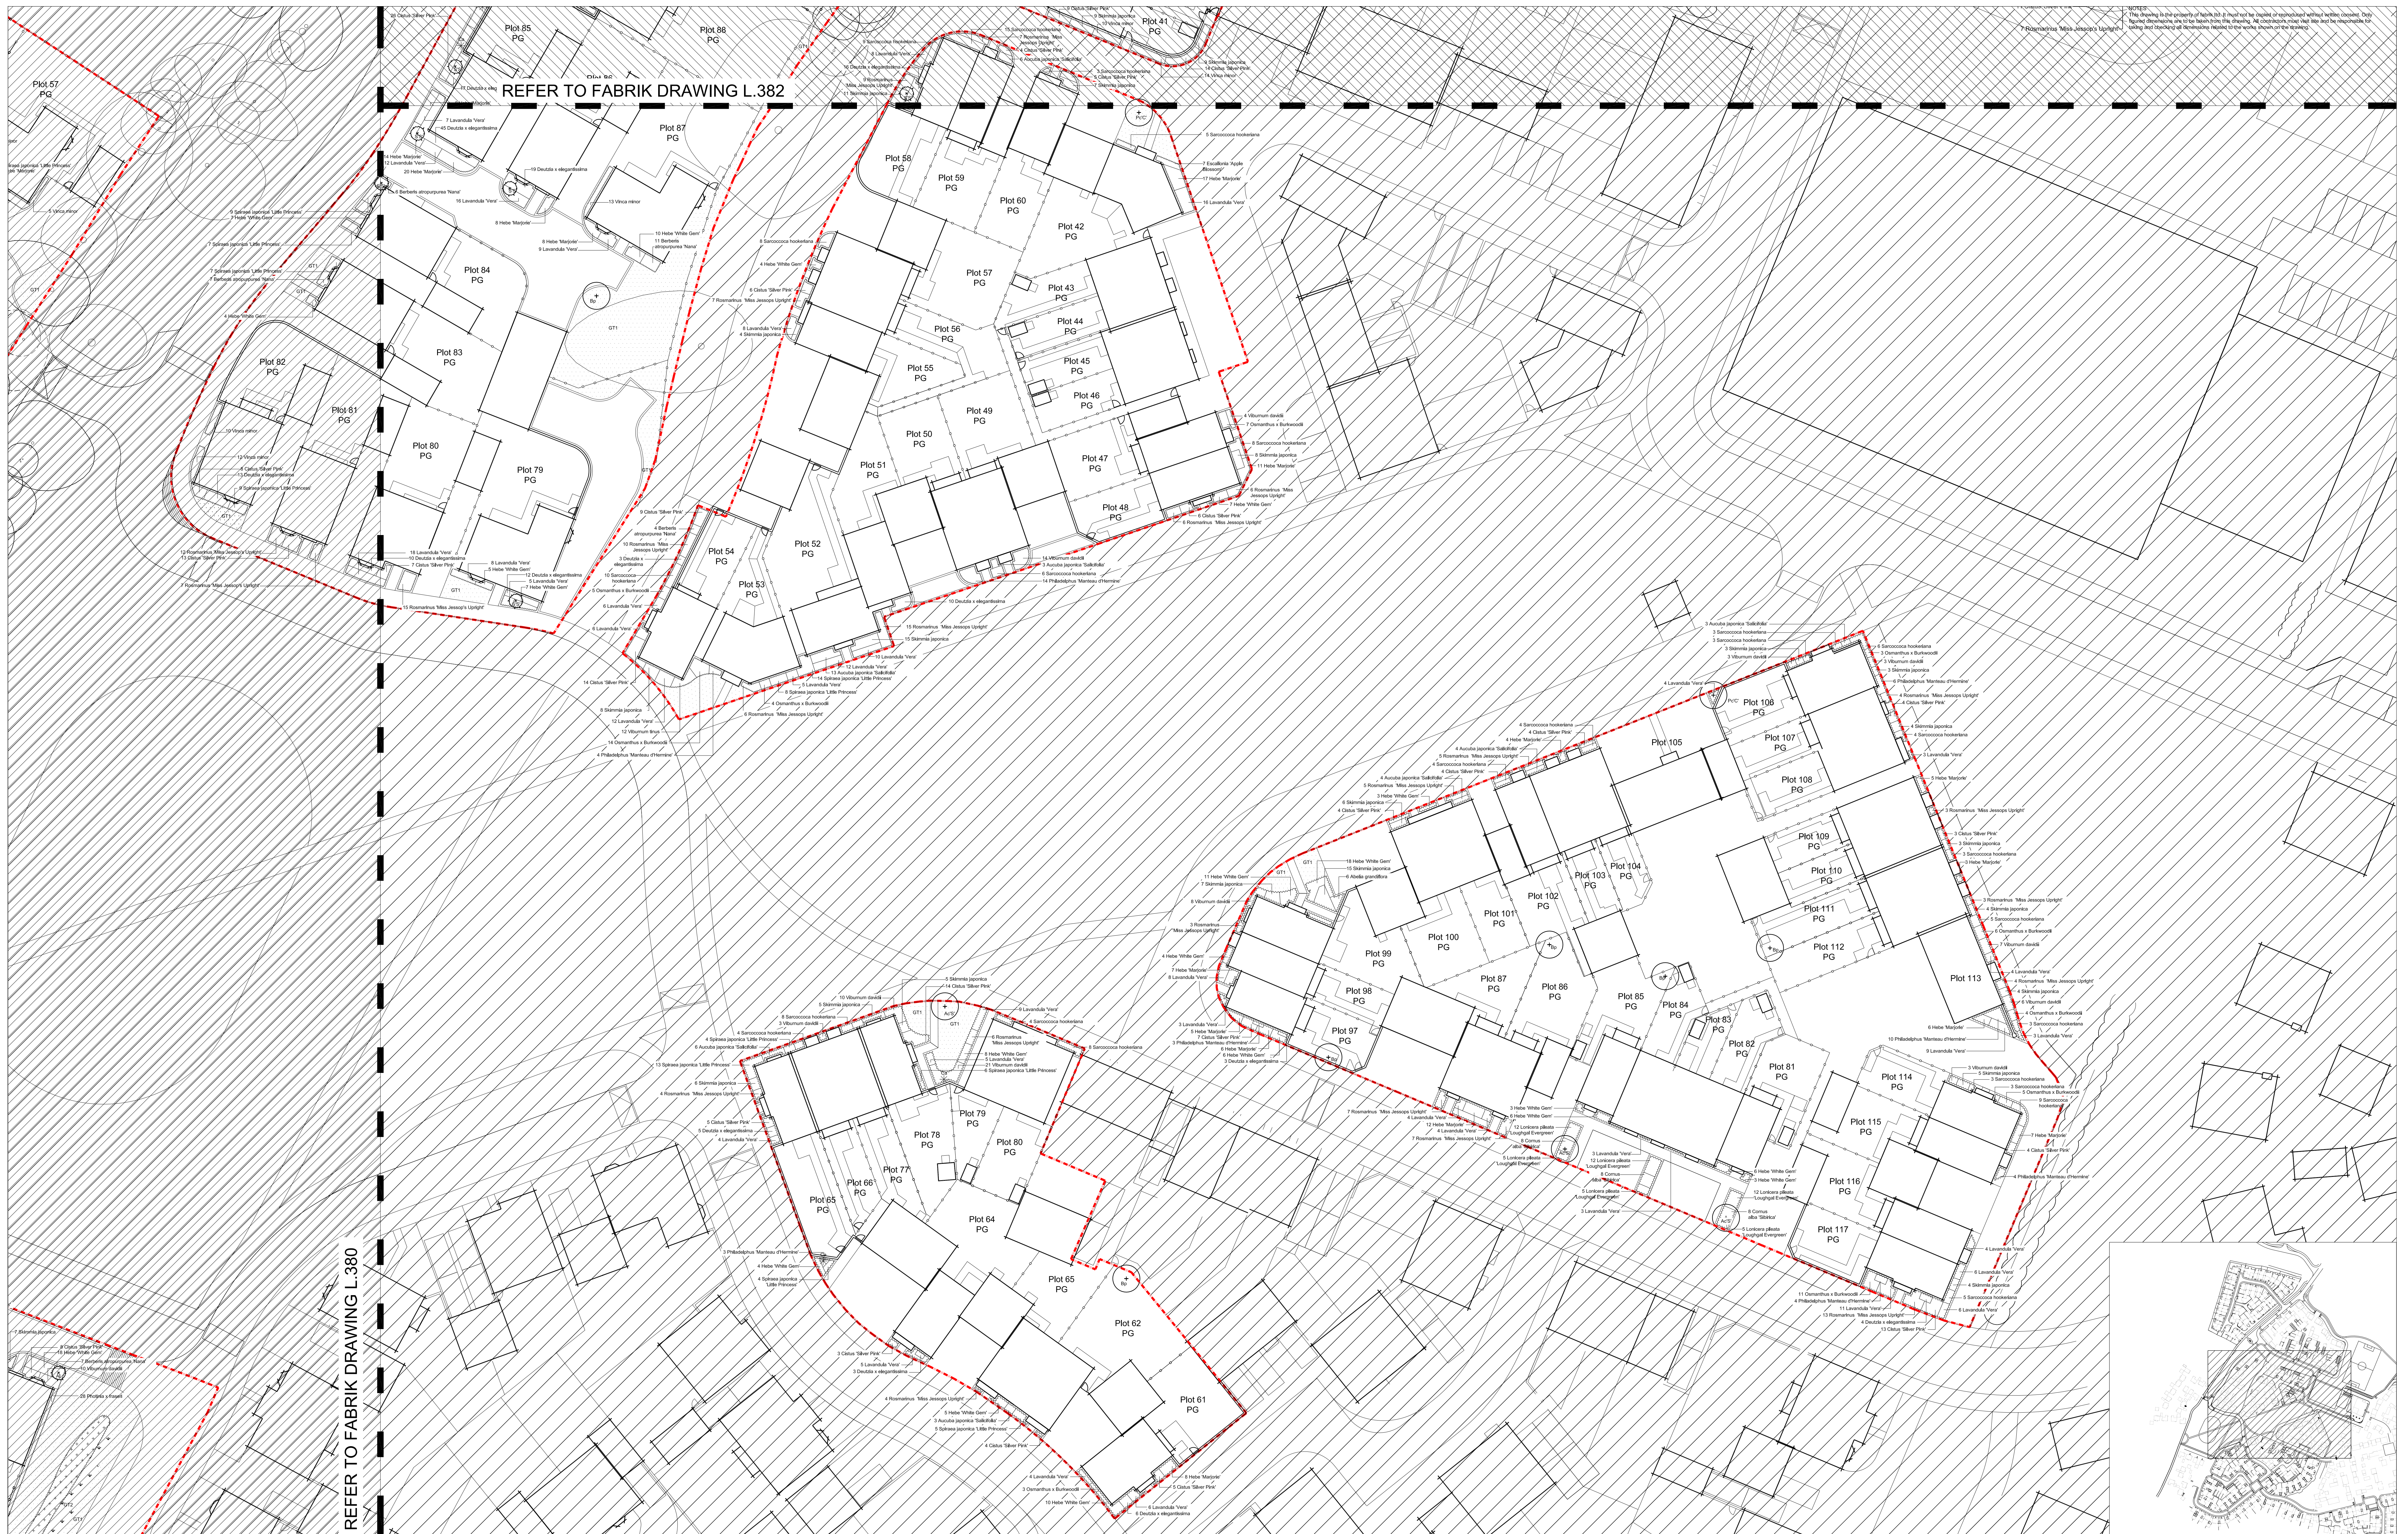

fabrik


38a High Street
Alton
Hampshire
GU34 1BD
T : 01420 593250
F : 01420 544243
E : studio@fabrikuk.com
F : 01420 544243

Refer to fabrik drawing L.380 for plant schedule and specification notes.

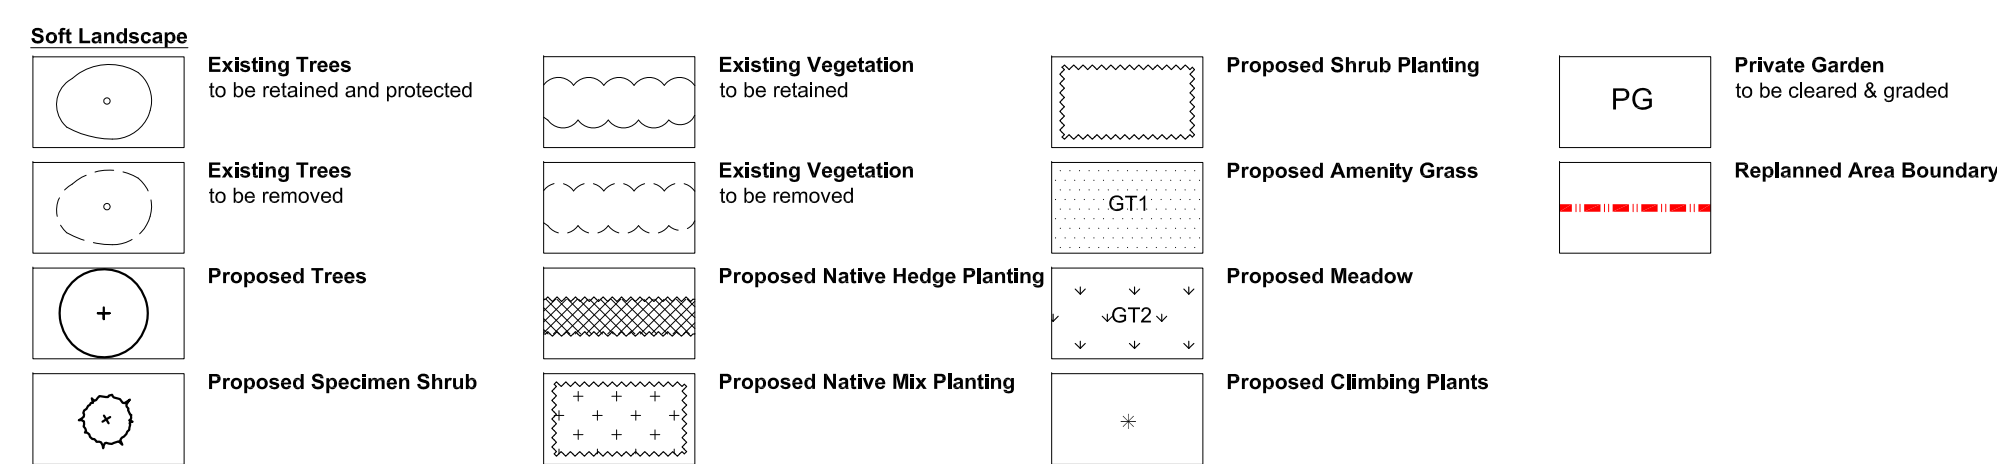

External References:
J:\Job Files\1530 Felpham, Bognor Regis\Drawings\Architect\ Recvd-15-08-25\ SITE LAYOUT PH 4 5 REPLAN_19 - Standard\SITE LAYOUT PH 4 5 REPLAN_19 copy.dwg

No.	Date	Reason	Name
-----	------	--------	------

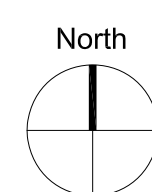

Project
Felpham, Bognor Regis
for Barratt Homes

Drawing

Detailed Planting Plan
Phase 4/5 Replanned areas

Scale
1 : 250@A0

Drawing No.
D1530.L.381

- ☐ Preliminary
- ☒ Issued for Planning Approval
- ☐ Issued for Construction

Drawing sheet size - A0

Date
Sept 15

Drawn
me
Revision

☐ Issued for Design/Information
☐ Issued for Tender
☐ As Built

Copyright Reserved ©