

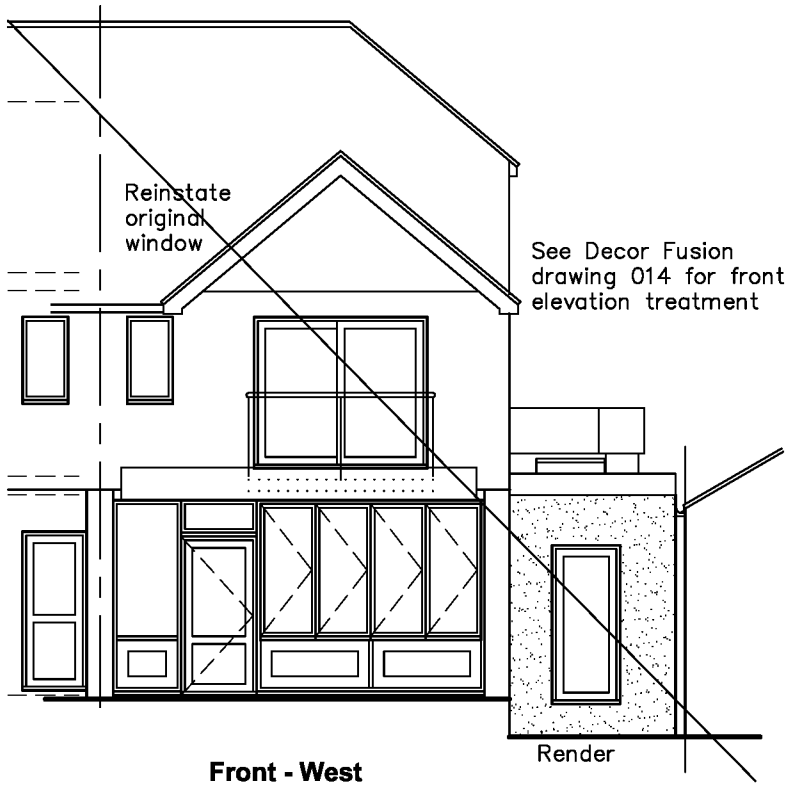



Front - West

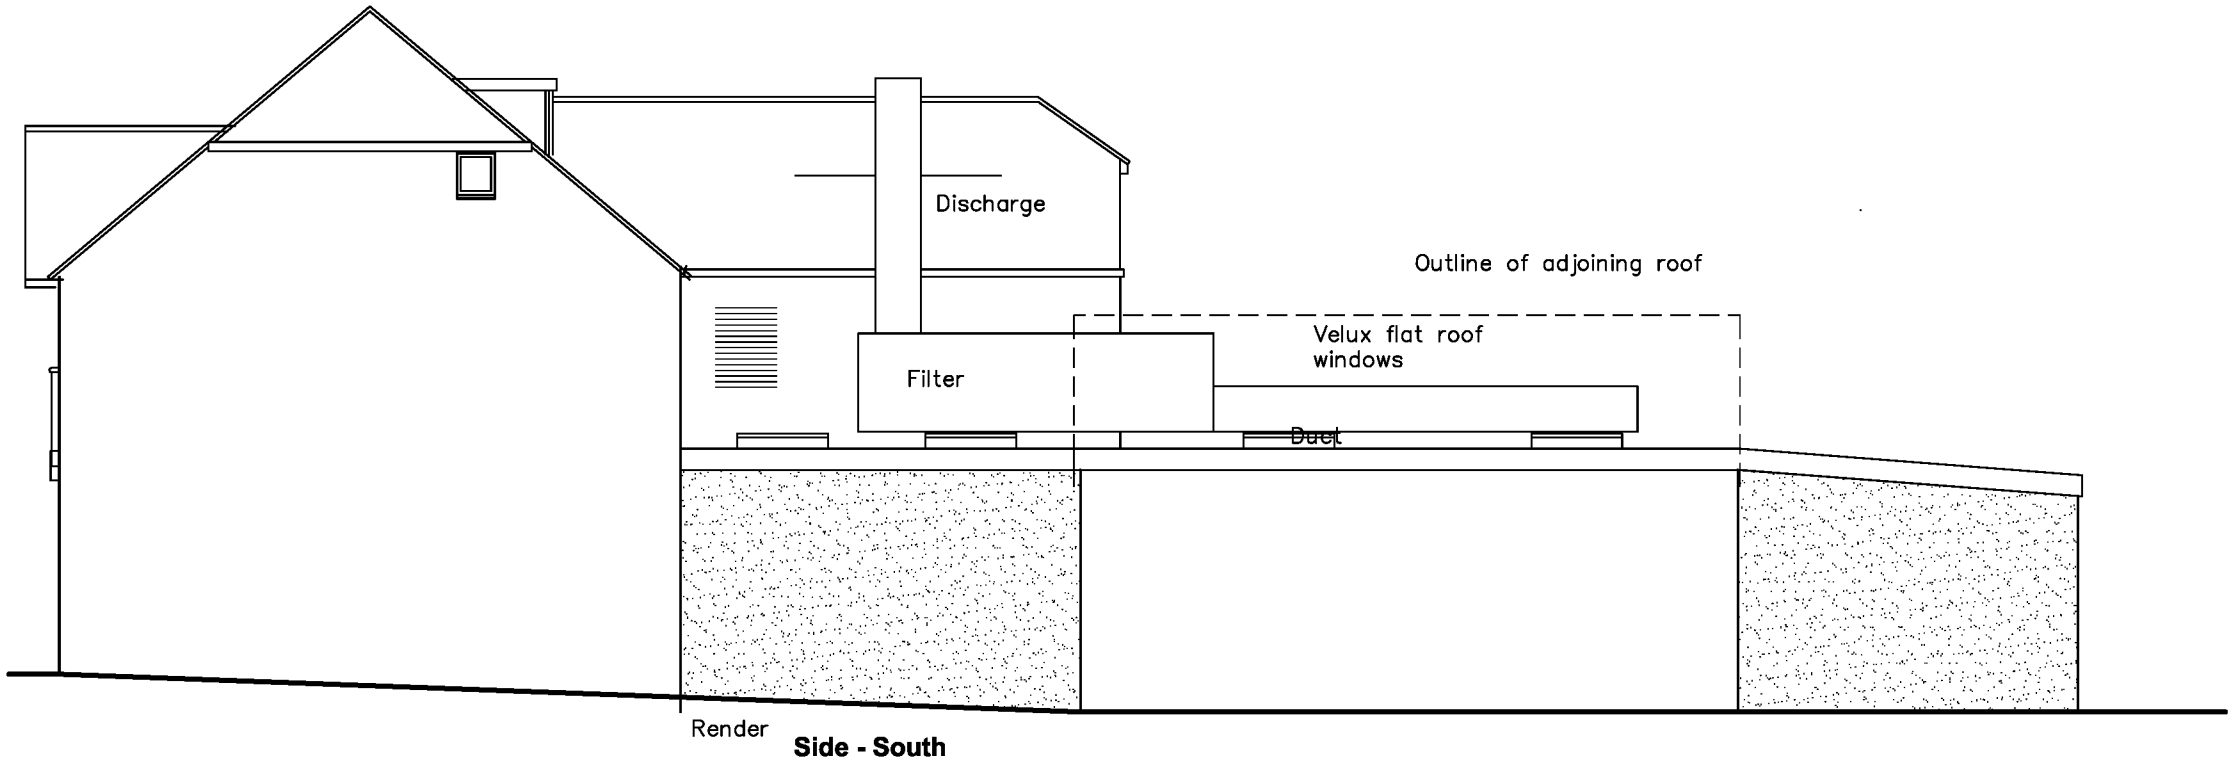

Side - South

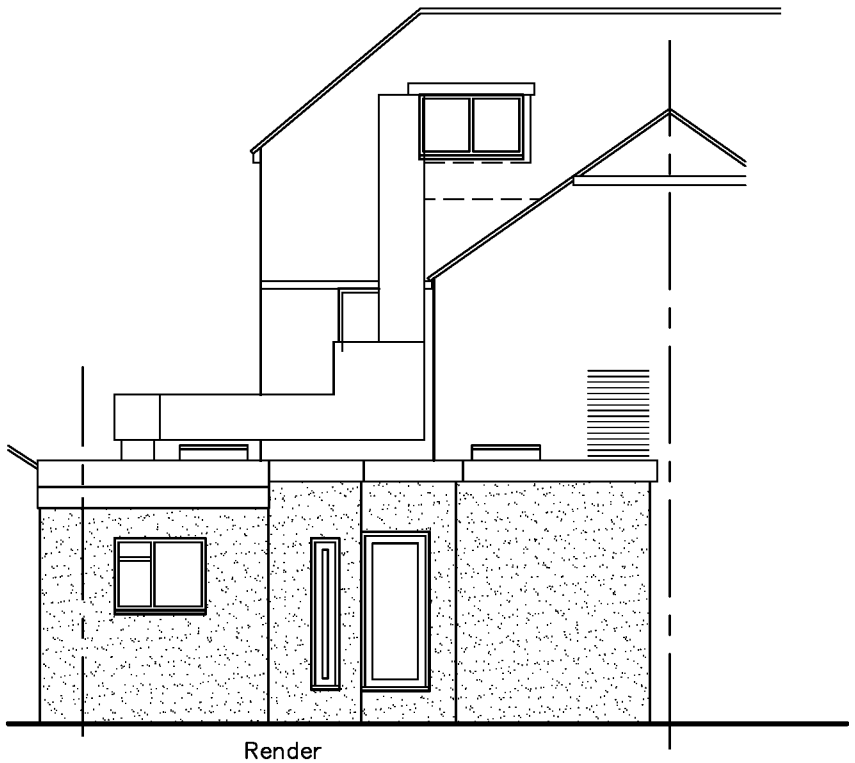

Rear - East

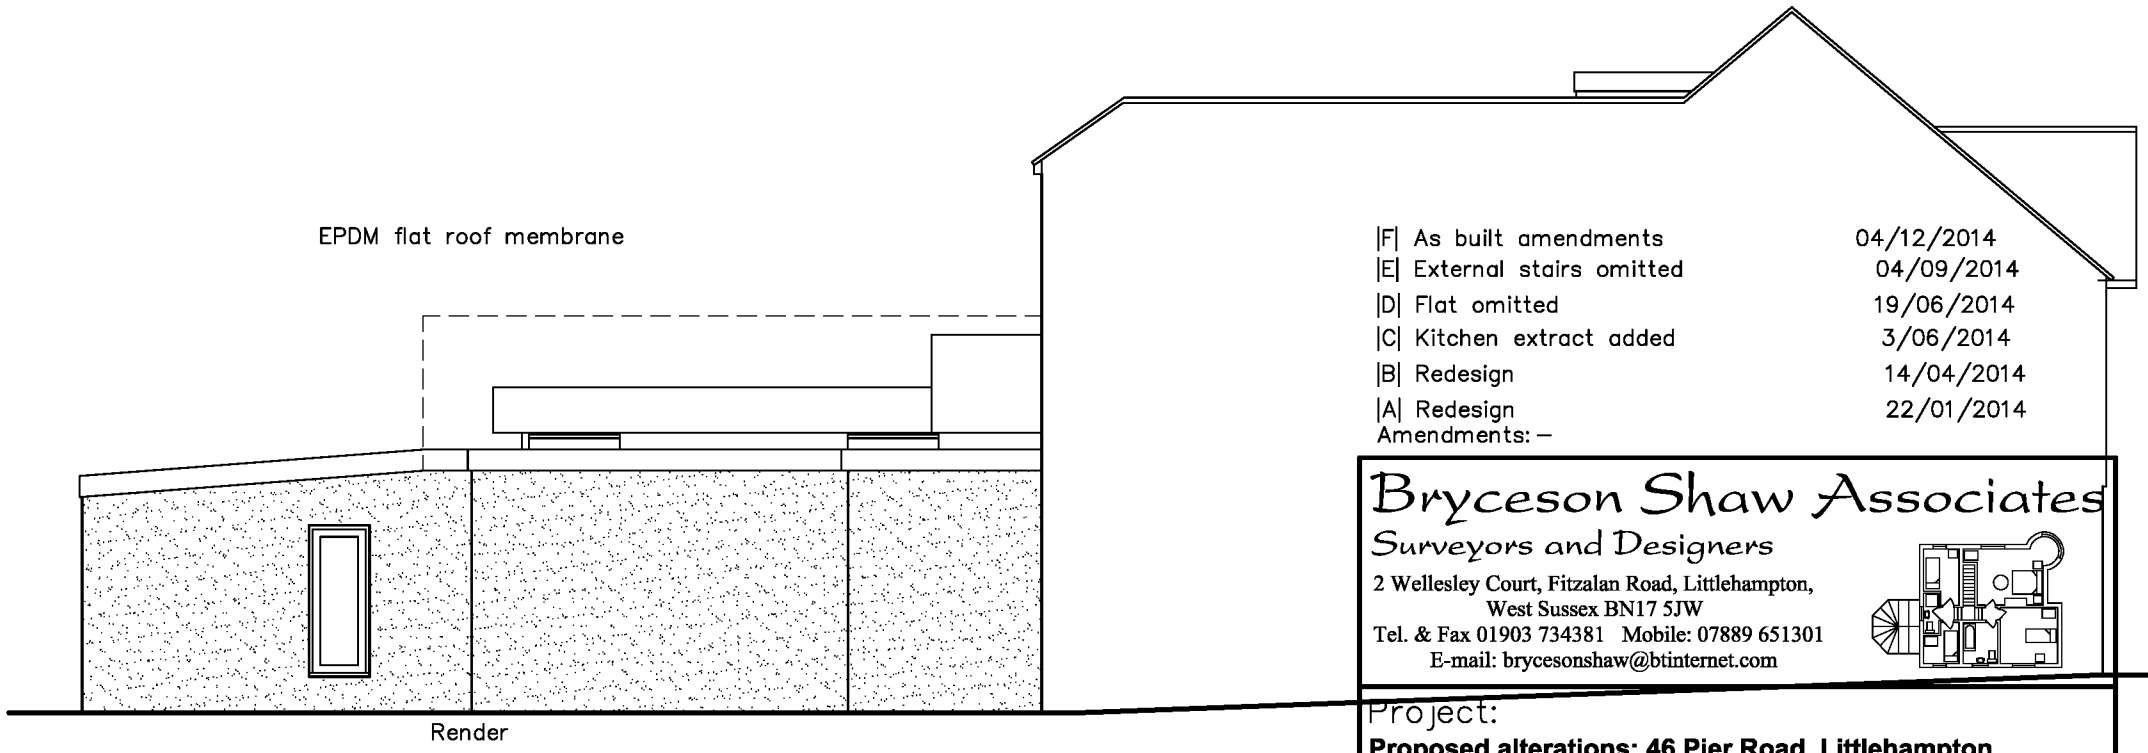

Sectional - North

|F| As built amendments	04/12/2014
|E| External stairs omitted	04/09/2014
|D| Flat omitted	19/06/2014
|C| Kitchen extract added	3/06/2014
|B| Redesign	14/04/2014
|A| Redesign	22/01/2014

Amendments: –

Bryceson Shaw Associates
Surveyors and Designers
2 Wellesley Court, Fitzalan Road, Littlehampton,
West Sussex BN17 5JW
Tel. & Fax 01903 734381 Mobile: 07889 651301
E-mail: brycesonshaw@btinternet.com

Project:
Proposed alterations; 46 Pier Road, Littlehampton BN17 5LW

Drawing:
Elevations as proposed

For:
The Gravy Boat

Drawn: PKS	Date: **November 2013**
Scales: **1:100**	No: **1501/01/04/F**

To scale when printed on A3

ARUN DISTRICT COUNCIL LU/180/15/PL