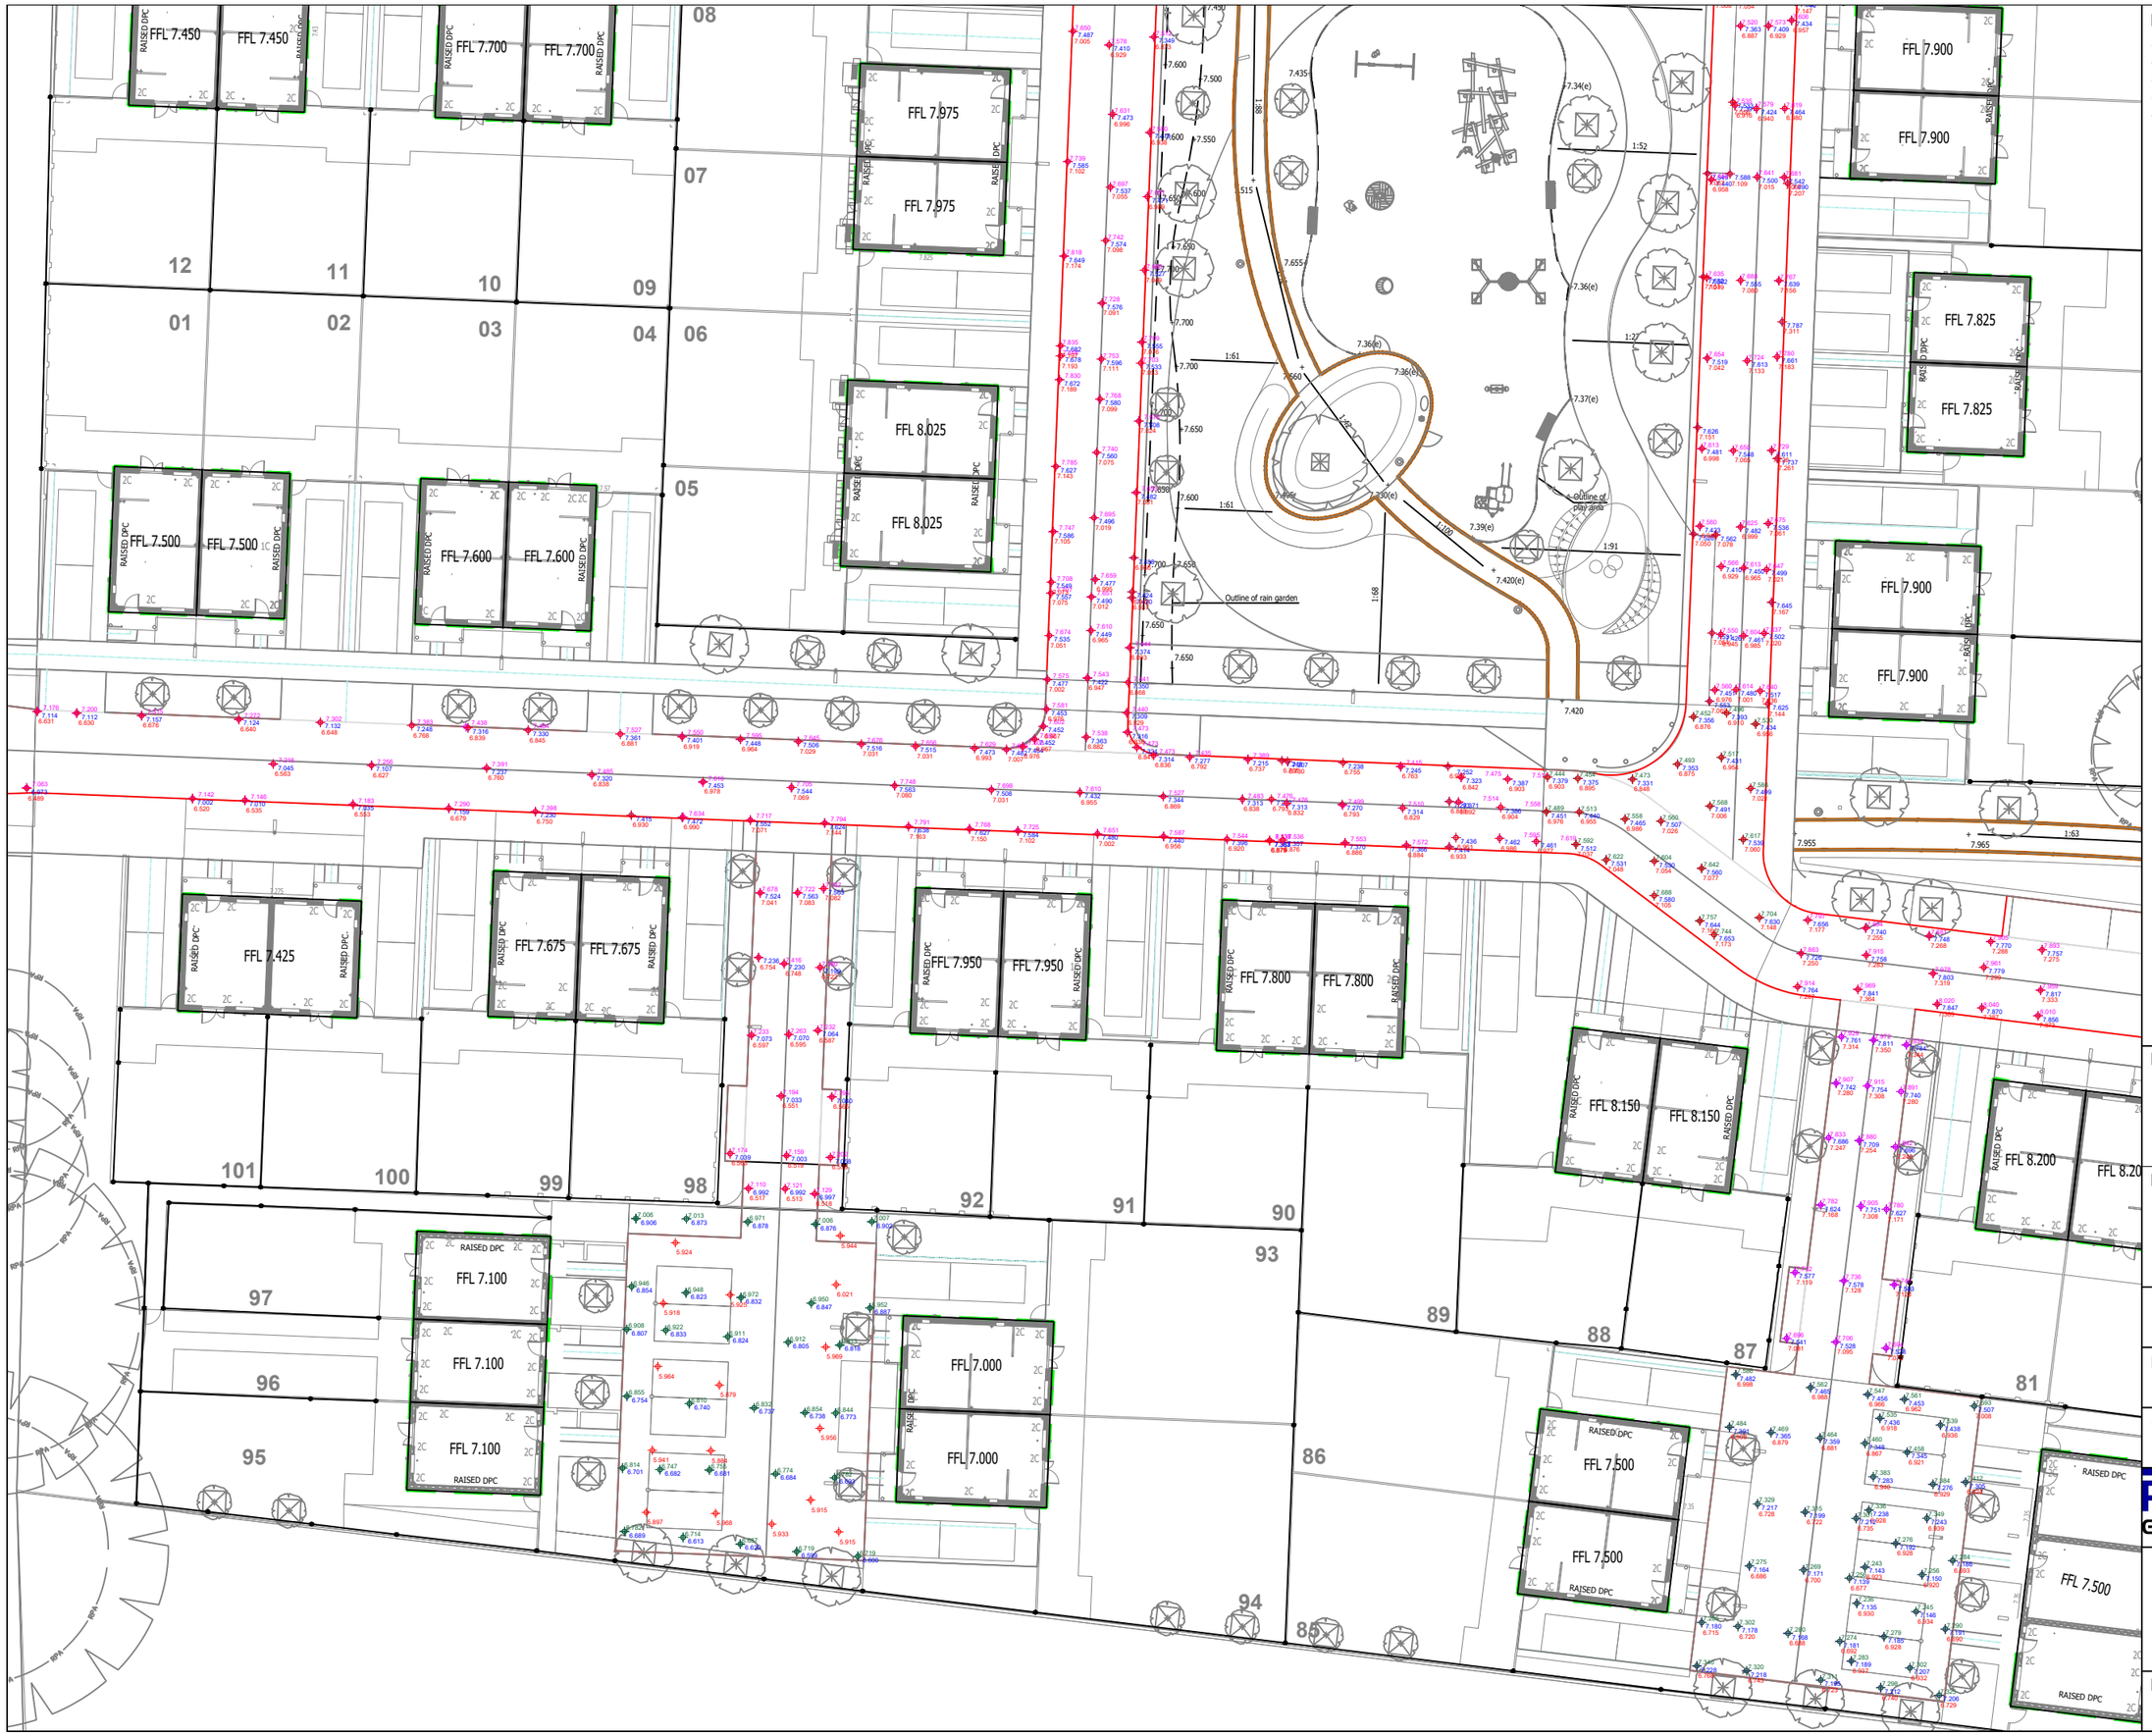

Notes

X.XXX - Formation Level

X.XXX - Type 1 Level

X.XXX - Base Level

X.XXX - Binder Level

X.XXX - Surface Level

Project Name:

Littlehampton North

Drawing Title:

Road As Built Survey
Sheet 2 of 4

Scale

1:400 at A3

Drawn	Project No:
M MOSSOP	PAR/468
Checked	Date
-	31/10/2025

PARCHOW GROUNDWORKS LTD

New Down Lane, Cosham
Waterlooville. PO7 5SE
023 9237 8572

Drawing No:	Revision
PAR/468/S-102	01