


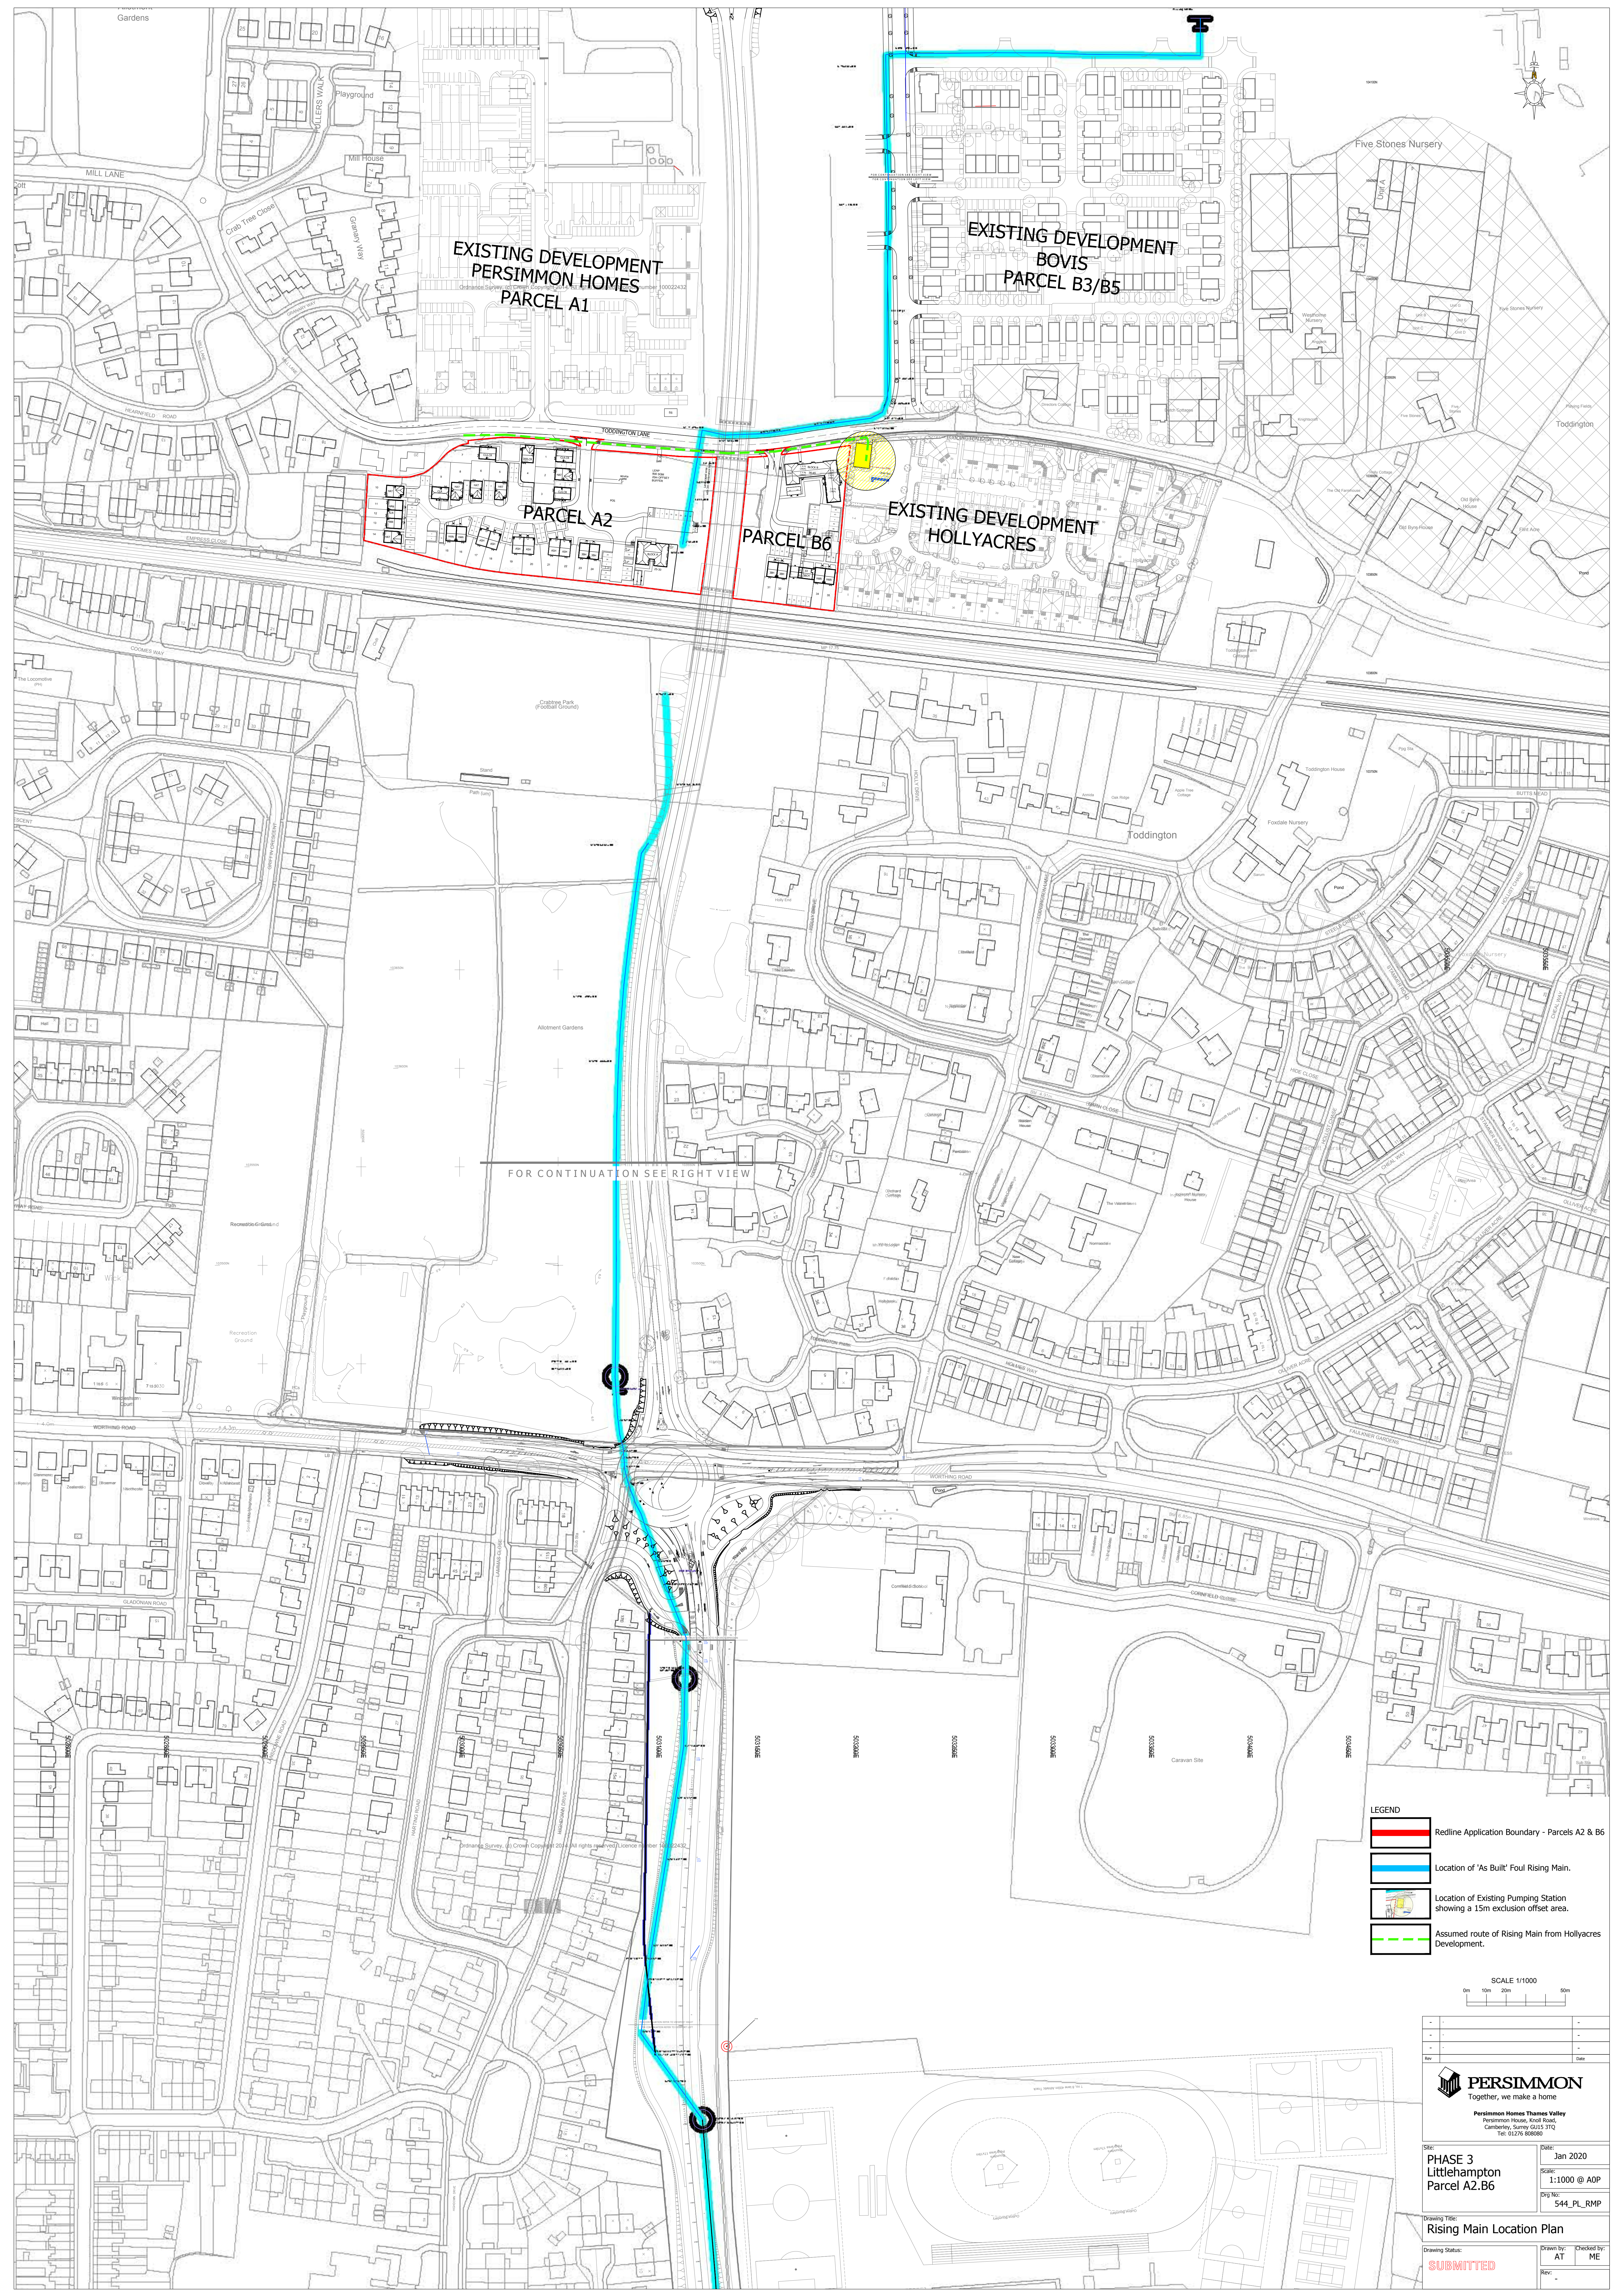

EXISTING DEVELOPMENT
PERSIMMON HOMES
PARCEL A1

EXISTING DEVELOPMENT
BOVIS
PARCEL B3/B5

PARCEL A2

PARCEL B6

EXISTING DEVELOPMENT
HOLLYACRES

FOR CONTINUATION SEE RIGHT VIEW

- LEGEND
- Redline Application Boundary - Parcels A2 & B6
 - Location of 'As Built' Foul Rising Main.
 - Location of Existing Pumping Station showing a 15m exclusion offset area.
 - Assumed route of Rising Main from Hollyacres Development.

SCALE 1/1000
0m 10m 20m 50m

PERSIMMON
Together, we make a home
Persimmon Homes Thames Valley
Tel: 01276 808890

Site: **PHASE 3
Littlehampton
Parcel A2,B6**
Date: Jan 2020
Scale: 1:1000 @ AOP
Dwg No: 544_PL_RMP

Drawing Title: **Rising Main Location Plan**
Drawing Status: **SUBMITTED**
Drawn by: AT
Checked by: ME
Rev: