


Flexible Footway Crossing

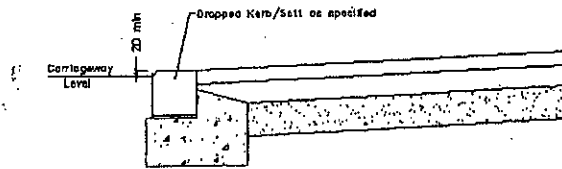

Note
Light vehicle construction to be used unless otherwise specified.


Light Vehicles

40 Surface Course - H.R.A. to Cl. 11055
60 D.B.M. Binder Course - D.B.M. to Cl. 806
150 Type 1 Sub-Base to Cl. 803


Heavy Vehicles

40 Surface Course - H.R.A. to Cl. 11055
60 D.B.M. Binder Course - D.B.M. to Cl. 806
200 D.B.M. Base Course - D.B.M. to Cl. 903
150 Type 1 Sub-Base to Cl. 803

To be used for crossings over pavements without verge or similar road margin.

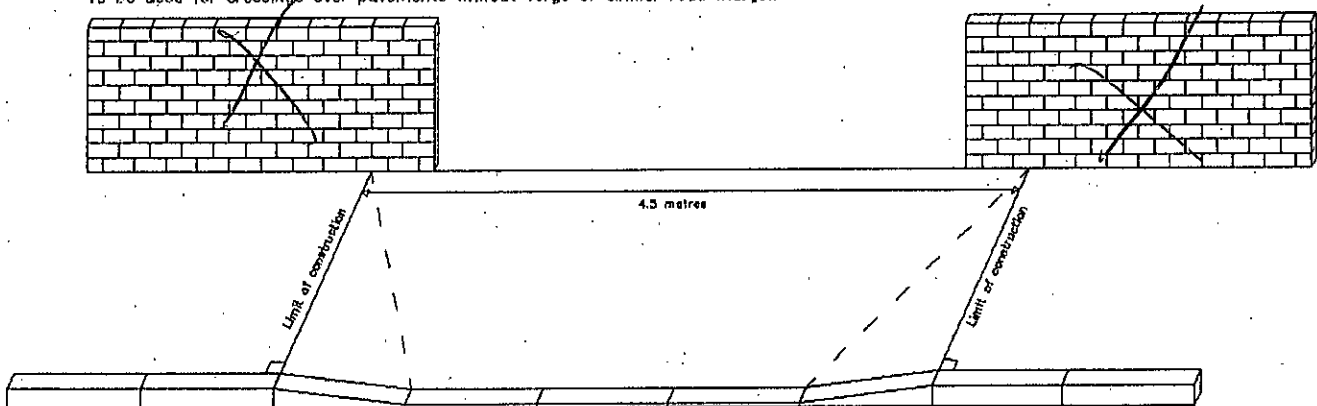

To be used for crossings with verge or similar road margin

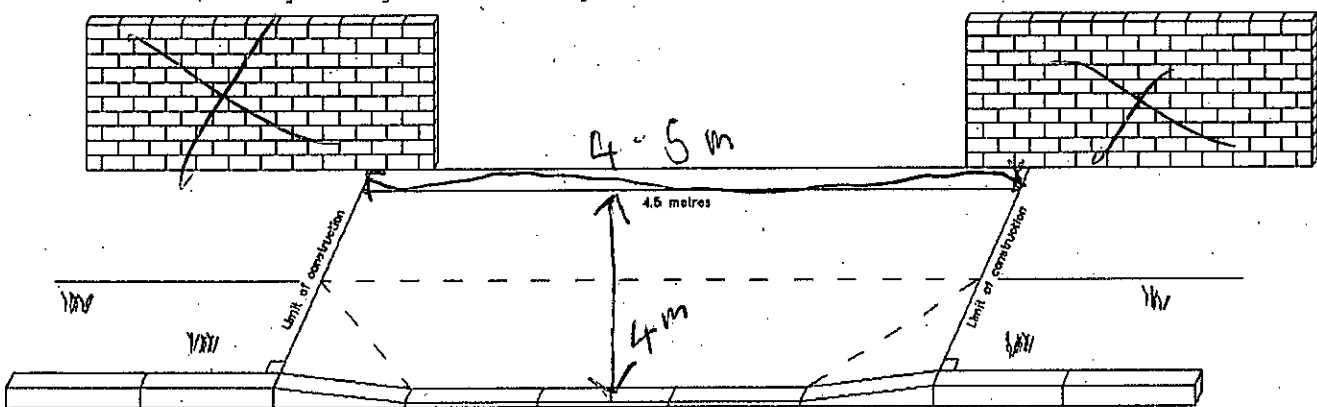

NOTES

Drawn: S.Meachim	✓	For comment
Chkd: B.Candy		For tender
Appd:		For construction
Date: 11/06/2010		As constructed
File ref: H:\Southern\Engineering\AutoCAD IWP Ref:		
Original Drawing Size: A4		
Scale: not to scale	Dimensions:	

Project Name

Drawing Title
Highway Construction Details
Typical Footway Crossing

Drawing No
KWS19

Rev

D

Original drawing

11/06/2010

Rev

Revision details

Chkd

Appd

Date

Director Operations Infrastructure
County Hall,
West Street
Chichester
West Sussex
PO19 1RH
(01243) 642105



REPRODUCED FROM 2007 ORDNANCE SURVEY MASTER MAPPING WITH THE PERMISSION OF THE CONTROLLER OF HER MAJESTY'S STATIONERY OFFICE. UNAUTHORISED REPRODUCTION INFRINGES CROWN COPYRIGHT, AND MAY LEAD TO PROSECUTION OR CIVIL PROCEEDINGS. LICENCE No. V.S.C.G. 100010485