

MASH & BARREL

CHURCH FARM HOLIDAY PARK


PROPOSED COMPLEX SECTIONS

- Finishes Key:-
- ① Existing openings infilled with brickwork to match existing
 - ② New Air Intake & Exhaust ducts to M&B Kitchen (Self Colour Metal)
 - ③ New circular rooflights to Arcade
 - ④ New M&B jumbrellas to external deck area
 - ⑤ New aluminium polyester powder coated doors/windows (Colour: White RAL 9010)
 - ⑥ New Stainless Steel & glass balustrading to external deck
 - ⑦ Timber framed external walling covered with Eternit Weather Boarding (Ref: S14 Atlas Brown) with 100mm wide Siding Trims (Ref: S01 White)
 - ⑧ New aluminium polyester powder coated parapet capping (Colour: White RAL 9010)
 - ⑨ Existing & extended decking area re-boarded/boarded in tanalised SW decking boards
 - ⑩ Feature external wall mounted lights


Copyright. This drawing is the property of A&M Architectural Partnership LLP. Its copyright and design content is reserved by them and the drawing is issued on the condition that it is not copied, reproduced, retained or disclosed to any other unauthorised person, either wholly or in part without the consent in writing of A&M Architectural Partnership LLP.

Verify all dimensions on site before commencing any work or preparing any shop drawings. All dimensions are in mm unless otherwise stated. Report any alterations or omissions to the Architect. This drawing incorporates information from other professions. A&M Architectural Partnership LLP cannot accept responsibility for the integrity and accuracy of such information. Any clarification and/or additions that are required appertaining to such information should be sought from the relevant profession or their appointed representative.


Rev	Details	Name	Date
A	Revised as Client comments.	tf	29.07.09
B	Proposed Kitchen Air Intake & extract revised as M&E consultants comments.	tf	09.10.09
C	Revised as Arun DC comments.	tf	09.10.09
D	Sections updated as per as built services installations.	tf	24.10.09

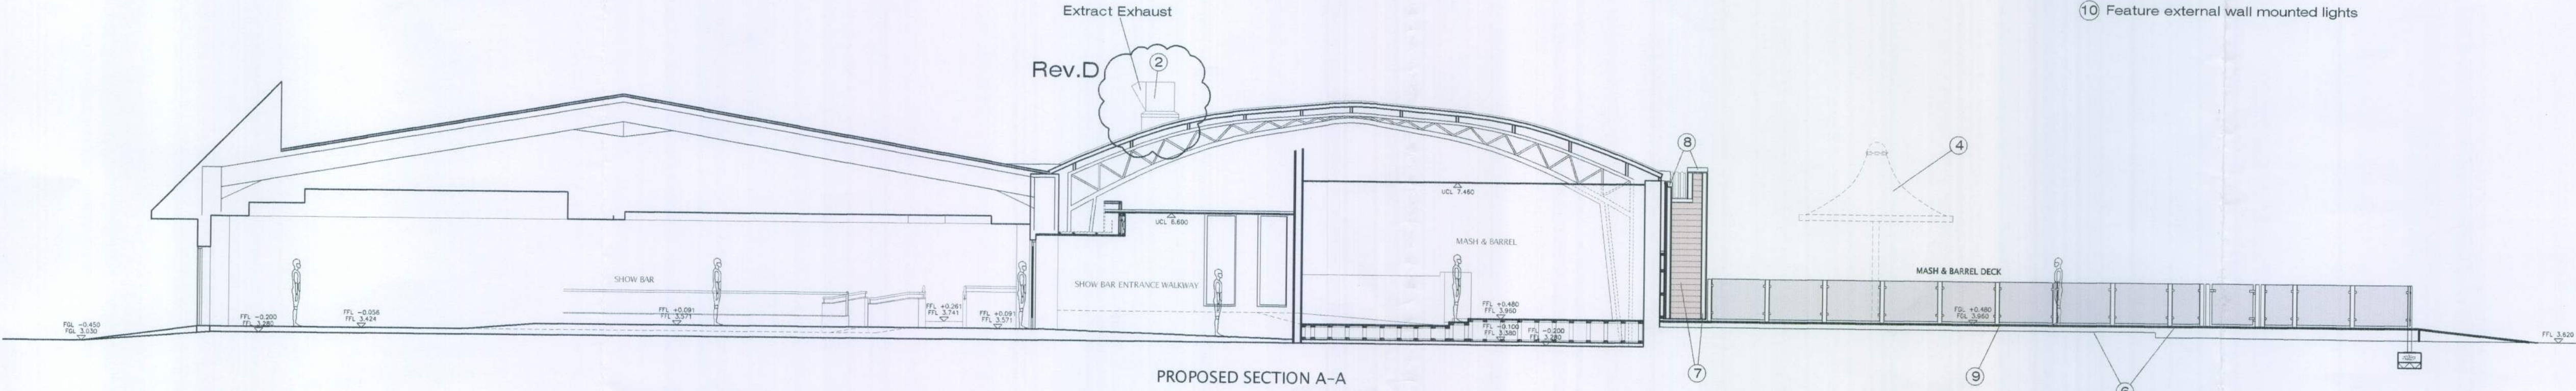

DATUM VALUE 0.00M

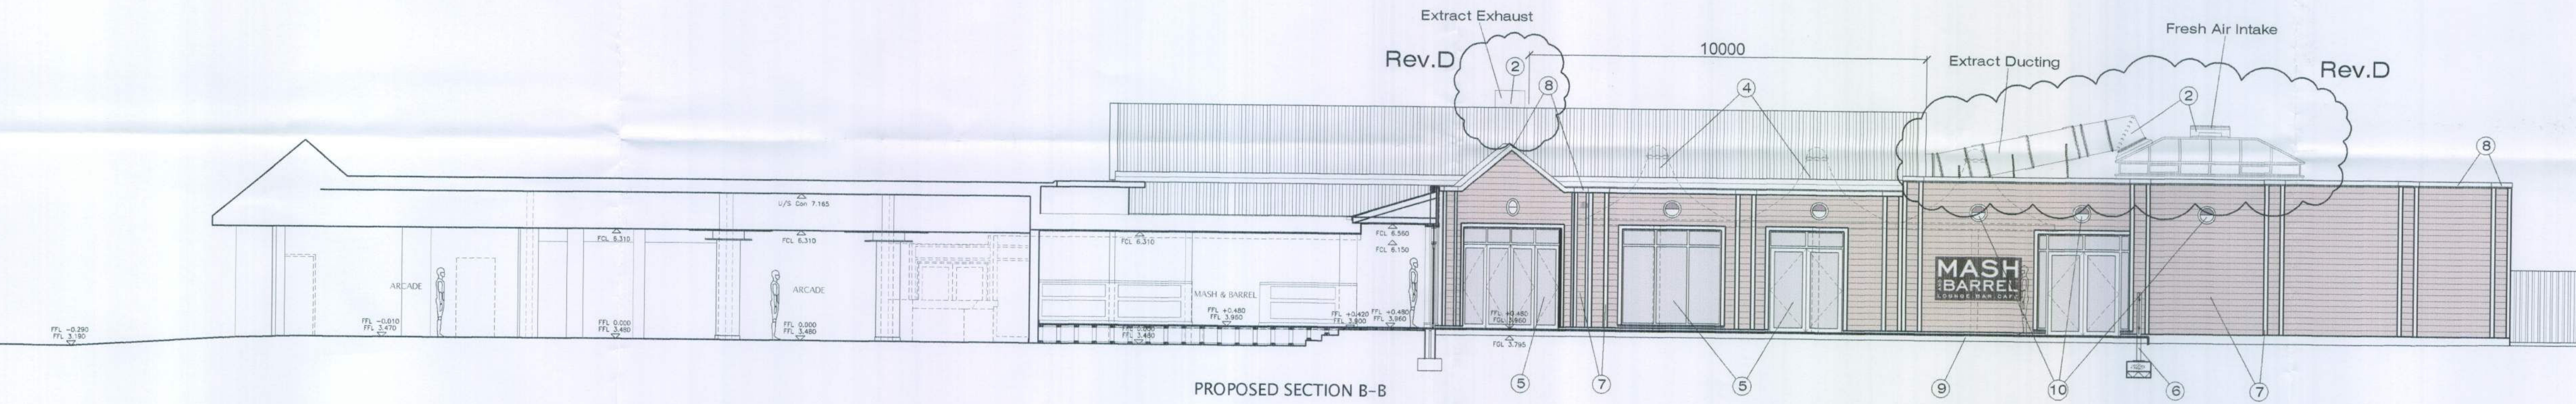

DATUM VALUE 0.00M

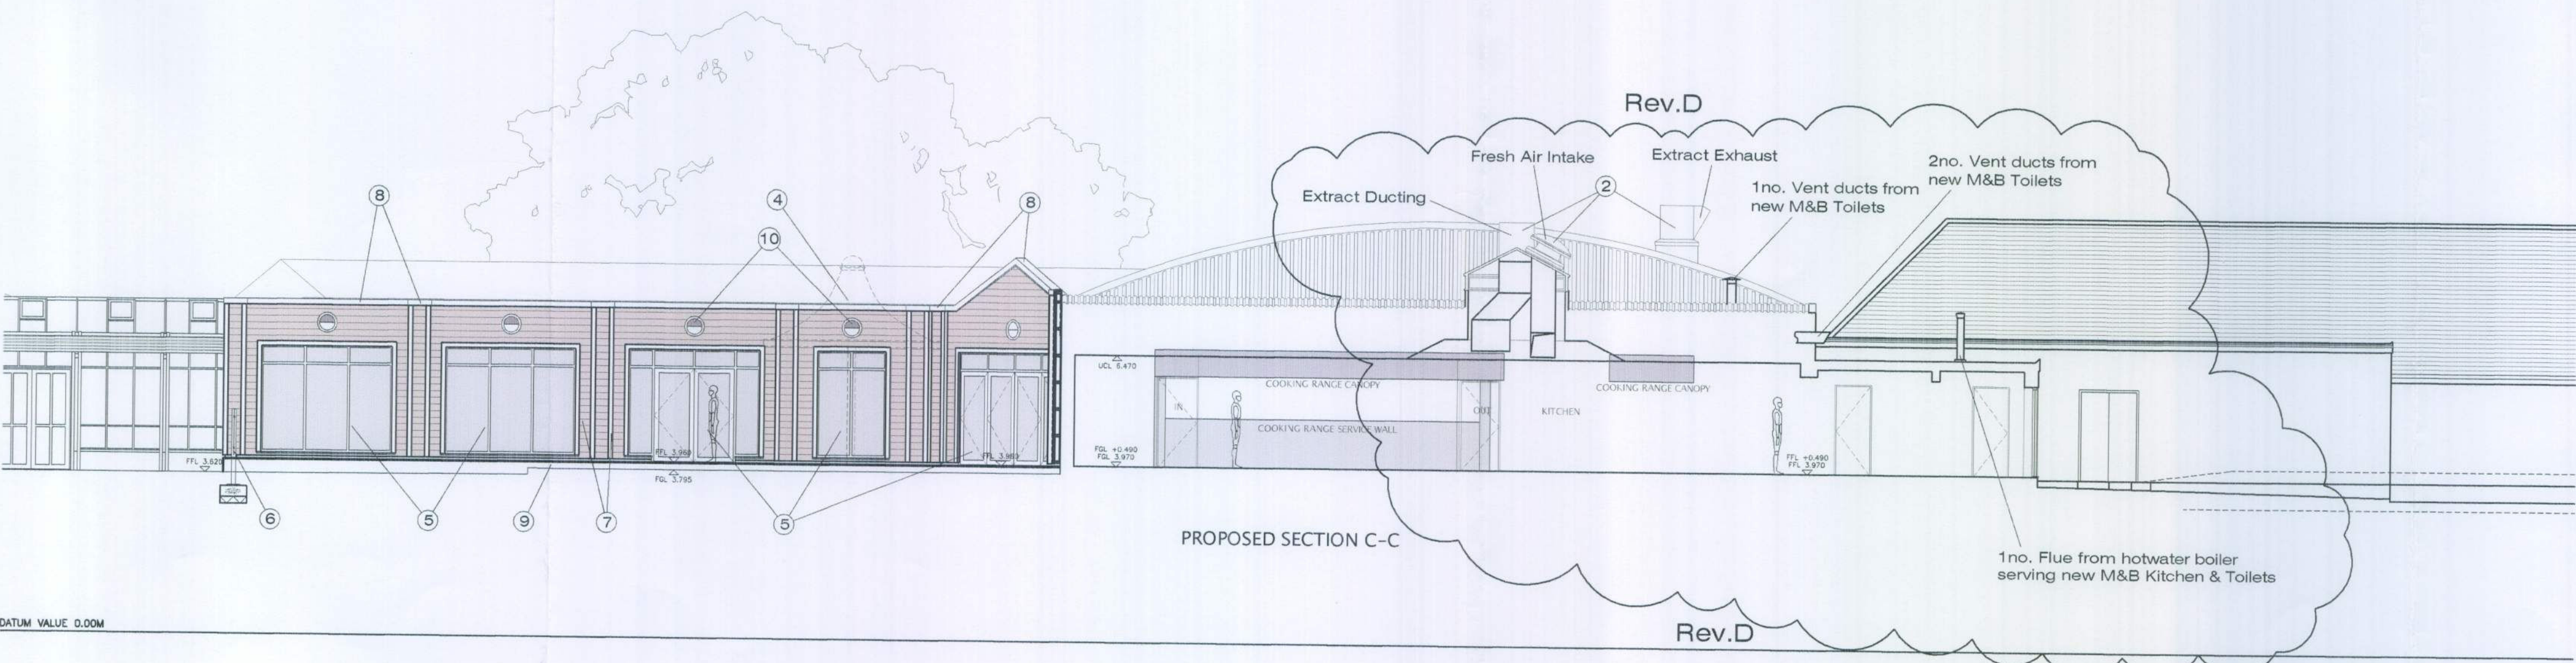

DATUM VALUE 0.00M



ARCHITECTURAL PARTNERSHIP LLP
40 CAMBRIDGE ROAD,
HASTINGS, EAST SUSSEX
TN34 1DT
T: 01424 200222
F: 01424 200333
E: admin@a-and-m.co.uk

Client	BOURNE LEISURE LTD.		
Project	CHURCH FARM HOLIDAY VILLAGE PAGHAM, Nr CHICHESTER, WEST SUSSEX. PO21 4NR		
Drawing Name	PROPOSED COMPLEX SECTIONS		
Status	PLANNING		
Scale	1:100 @ A1	Date	JULY 2009
Drawn By	tf	Checked By	.
Computer File Name	3010-135 Proposed Complex Sections.dwg		
Drawing No	3010-135	Revision	D