

ARUN DISTRICT COUNCIL:R/242/07/ 17/09/2007


ARUN DISTRICT COUNCIL
No. R 242 07
MINOR AMENDMENT
RECEIVED 15.08.08

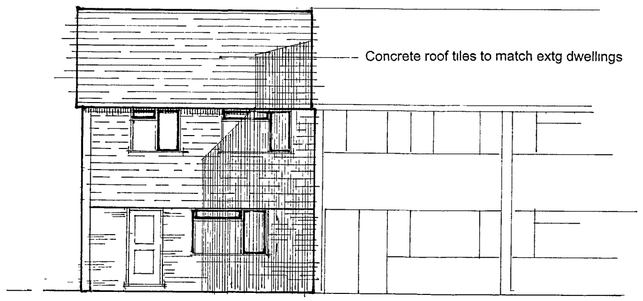


WEST ELEVATION 1.100

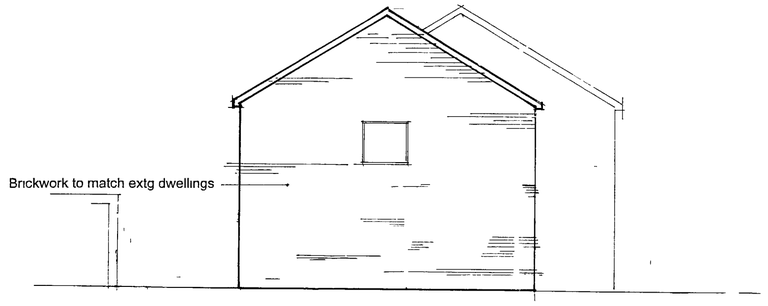


NORTH ELEVATION 1.100

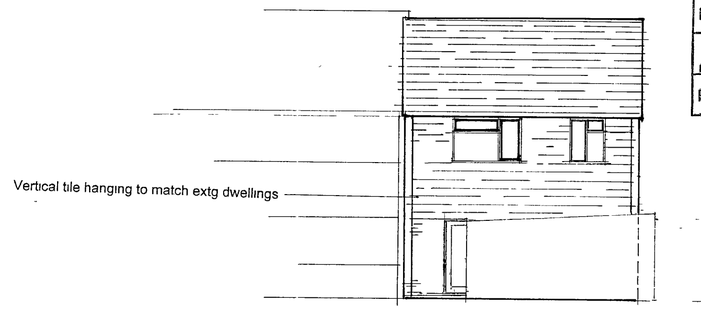


EAST.
~~SOUTH~~ ELEVATION 1.100

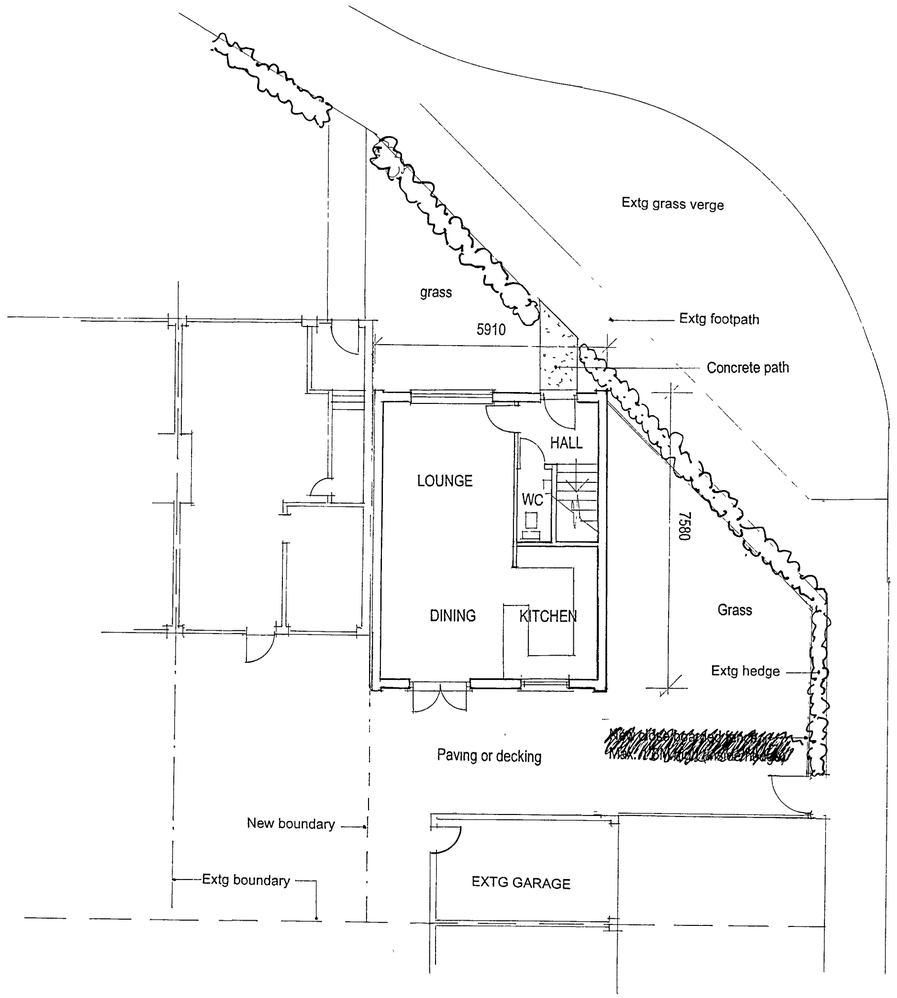

GROUND FLOOR PLAN 1.100

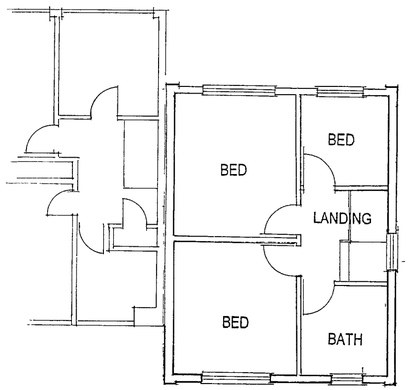

FIRST FLOOR PLAN 1.100

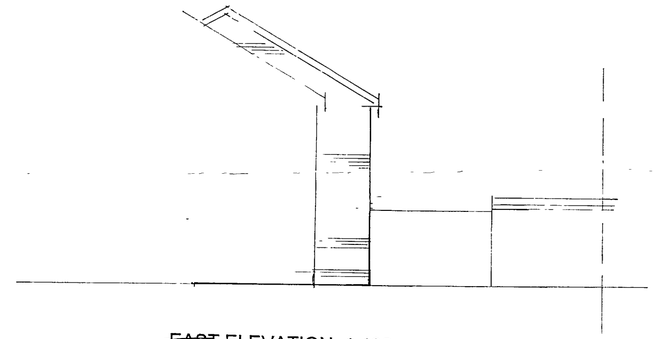

~~EAST~~ ELEVATION 1.100
SOUTH.

Dwg No: 2052
Proposed Two Storey House on Land Adjacent
To 6, Duncton Road, Rustington, BN16 3LA

ARW Design,89,South Street,Tarring,BN14 7ND
T:01903204652 M:07771851222
E:Arweeden1@aol.com

Scale: as noted Date: September 07