


Rev A: May 2026 / Add Redline Boundary to Vehicle Crossovers/ ARM

| Project                          |
|----------------------------------|
| Proposed Residential Development |
| Former Craft Works               |
| Mill Lane                        |
| Rustington                       |
| West Sussex                      |

---

Drawing

Proposed Hard / Soft Landscaping Layout

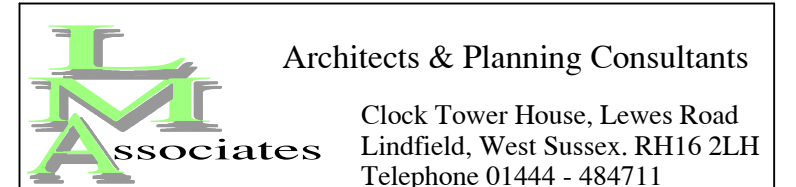

Client  
MJH Developments Limited

|             |                |                   |              |  |  |  |
|-------------|----------------|-------------------|--------------|--|--|--|
| Drawing no. | date<br>Oct 25 | scale<br>1:100@A1 | drawn<br>CRM |  |  |  |
| 2223.PLO4   | revisions      | A                 |              |  |  |  |

©THE CONTRACTOR SHOULD CHECK ALL DIMENSIONS ON SITE.  
NO DIMENSIONS TO BE SCALED FROM DRAWINGS.  
IT IS THE CONTRACTORS RESPONSIBILITY TO ENSURE COMPLIANCE  
WITH BUILDING REGULATIONS.

| <u>PLOT 1 PLANTING SPECIES</u> | <u>PLOT 2 PLANTING SPECIES</u> | <u>PLOT 3 PLANTING SPECIES</u> |
|--------------------------------|--------------------------------|--------------------------------|
| 3 no. Eunonymus                | 3 no. Skimmia Japonica         | 3 no. Eunonymus                |
| 3 no. Grasses                  | 3 no. Grasses                  | 3 no. Grasses                  |
| 3 no. Verbena                  | 3 no. Verbena                  | 3 no. Verbena                  |
| 3 no. Lavender                 | 3 no. Lavender                 | 3 no. Lavender                 |
| 3 no. Hebe                     | 3 no. Hebe                     | 3 no. Hebe                     |

NEW SIDE AND REAR BOUNDARY TREATMENTS TO BE 1.8m CLOSE BOARDED FENCE WITH SIDE ACCESS GATE