


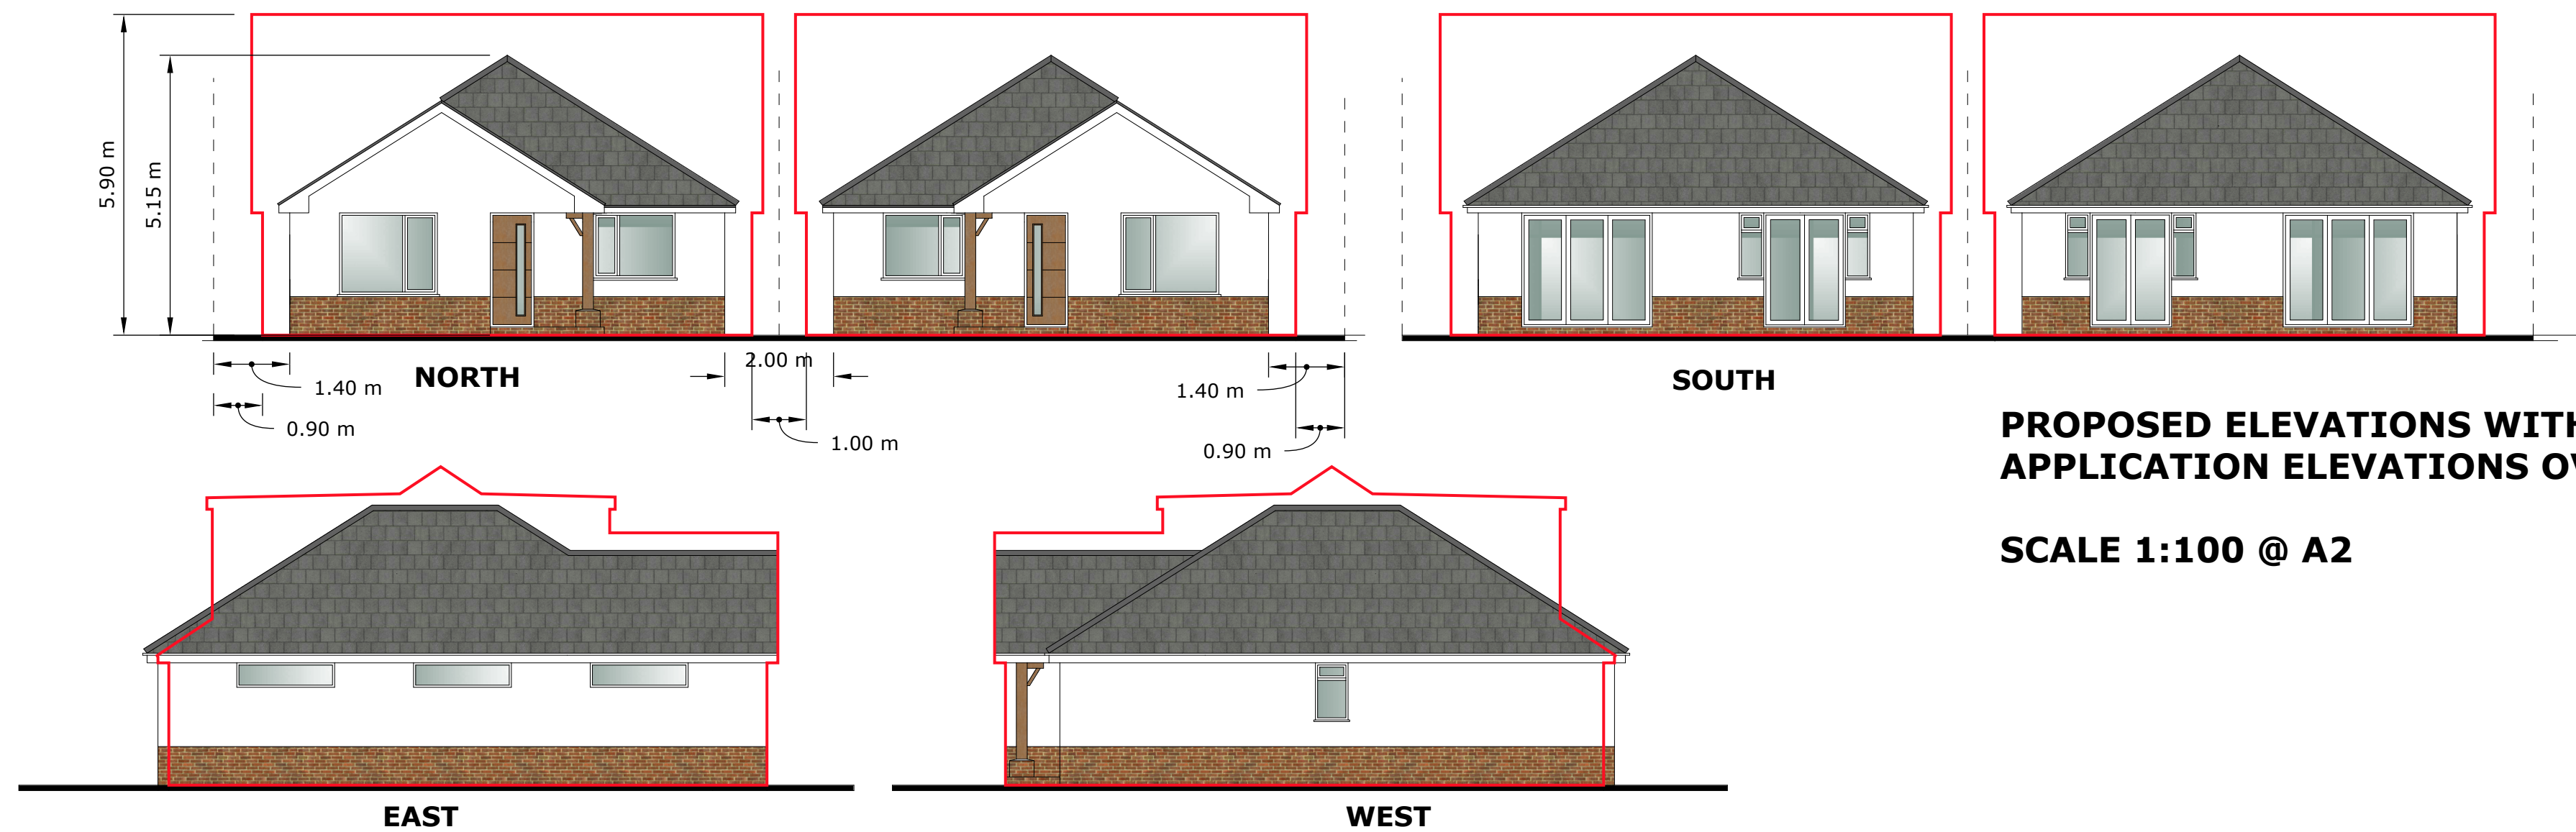

PROPOSED ELEVATIONS WITH PREVIOUS APPLICATION ELEVATIONS OVERLAID IN RED.

SCALE 1:100 @ A2

PREVIOUS FOOTPRINT SHOWN IN RED - IN RELATION TO CURRENT PROPOSED SCHEME.

SCALE 1:200 @ A2

