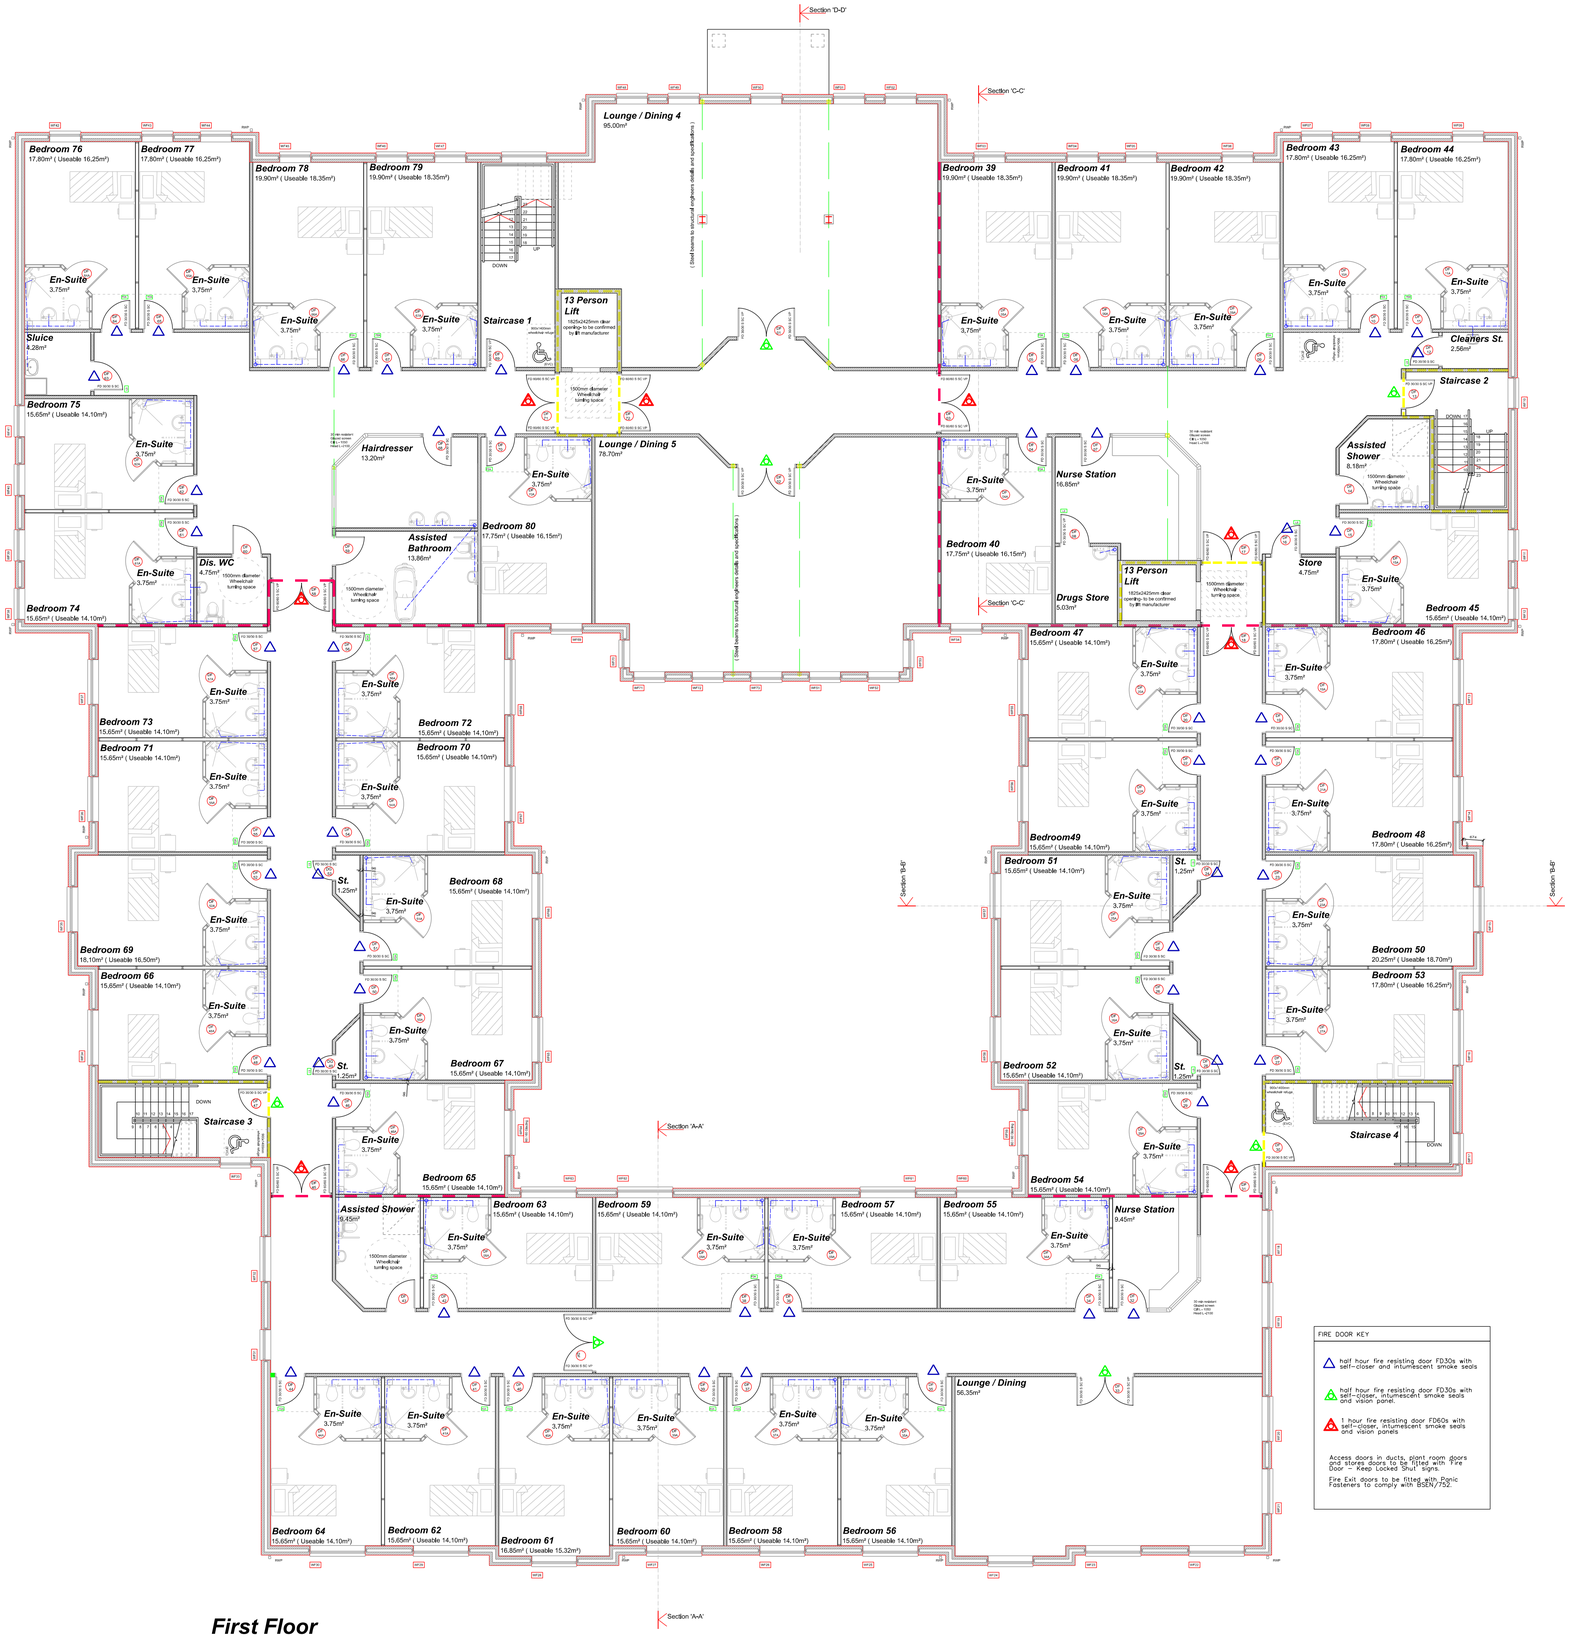

First Floor

AS BUILT FIRST FLOOR PLAN

FIRE DOOR KEY

- half hour fire resisting door FD30s with self-closer and intumescent smoke seals
- half hour fire resisting door FD30s with self-closer, intumescent smoke seals and vision panel
- 1 hour fire resisting door FD60s with self-closer, intumescent smoke seals and vision panels

Access doors in ducts, plant room doors and stores doors to be fitted with 'Fire Door – Keep Locked Shut' signs.

Fire Exit doors to be fitted with Panic Fasteners to comply with BS EN 179.

REVISION DATE / DESCRIPTION

REVISION 'A' 28/05/19
- RESITING OF FOOTPRINT

REVISION: A

NORTH

STAGE: AS BUILT

PROJECT
WALBERTON PLACE CARE HOME
YAPTON LANE
WALBERTON
ARUNDEL
WEST SUSSEX
BN18 0AS

DRAWING
FIRST FLOOR PLAN

PROJECT NO.	DRAWING NO.	REVISION
3112	L-02	A

DATE	SCALES	DRAWN BY
APR '19	1:100@A1	

MARIO MINCHELLA ARCHITECTS

UNIT 4, WITNEY WAY,
HI-TECH VILLAGE,
BOLDON BUSINESS PARK
TYNE AND WEAR
NE35 9PE

T: 0191 3082227

W: www.m-m-a.net
E: info@m-m-a.net

THIS DRAWING IS COPYRIGHT OF IMJAM LIMITED

NOT TO BE SCALED
ALL DIMENSIONS TO BE CHECKED ON SITE