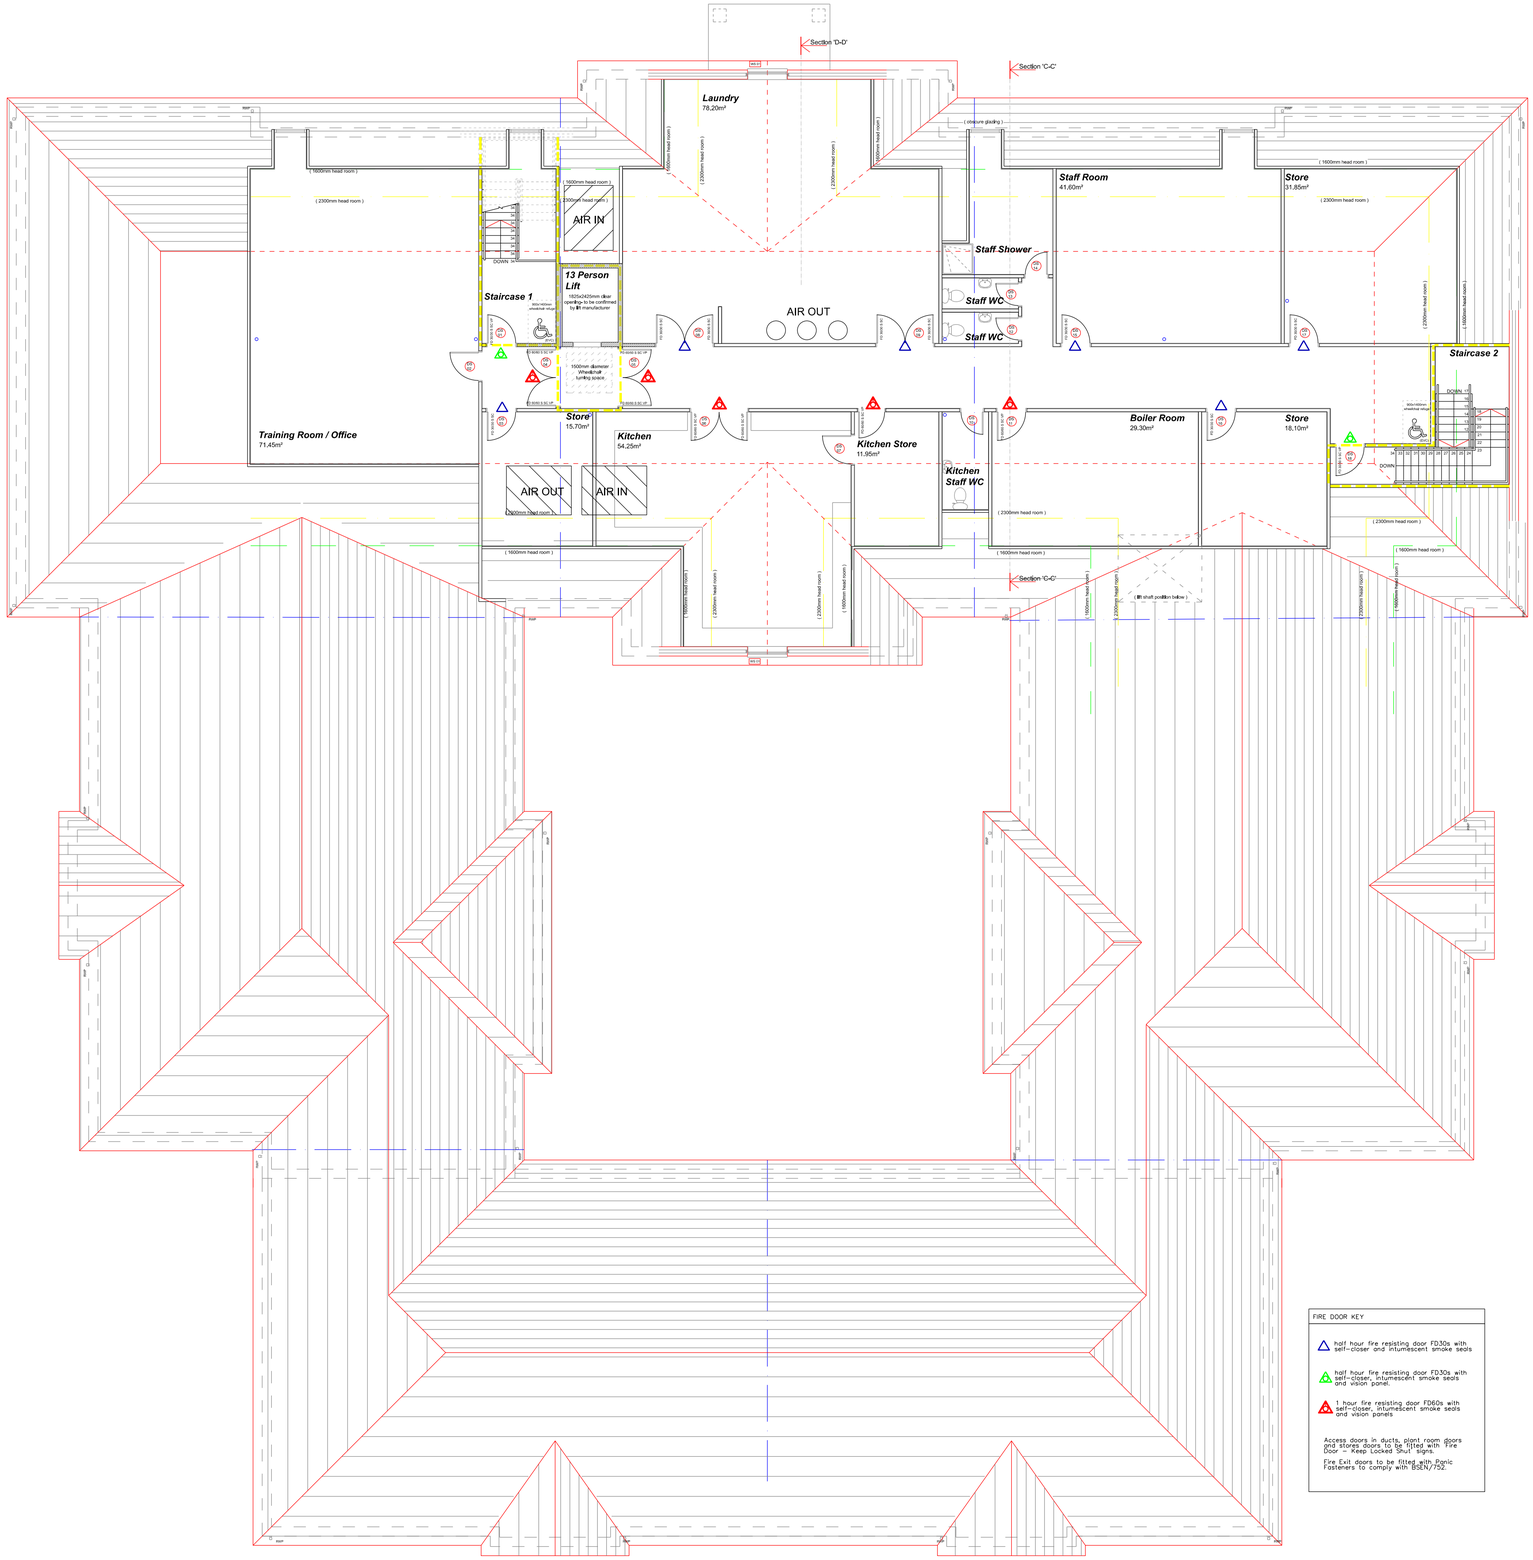

Second Floor

AS BUILT SECOND FLOOR PLAN

FIRE DOOR KEY

- half hour fire resisting door FD30s with self-closer and intumescent smoke seals
- half hour fire resisting door FD30s with self-closer, intumescent smoke seals and vision panel
- 1 hour fire resisting door FD60s with self-closer, intumescent smoke seals and vision panels

Access doors in ducts, plant room doors and stores doors to be fitted with 'Fire Door – Keep Locked Shut' signs.

Fire Exit doors to be fitted with Panic Fasteners to comply with BSEN/752.

REVISION DATE / DESCRIPTION

REVISION 'A' 08/05/19
- DUCTS ADDED IN LAUNDRY AND KITCHEN

REVISION 'B' 28/05/19
- RESITING OF FOOTRPINT

REVISION: B

NORTH

STAGE: AS BUILT

PROJECT

WALBERTON PLACE CARE HOME
YAPTON LANE
WALBERTON
ARUNDEL
WEST SUSSEX
BN18 0AS

DRAWING

SECOND FLOOR PLAN

PROJECT NO.	DRAWING NO.	REVISION
3112	L-03	B
DATE	SCALES	DRAWN BY
APR '19	1:100@A1	

MARIO MINCHELLA ARCHITECTS

UNIT 4, WITNEY WAY,
HI-TECH VILLAGE,
BOLDON BUSINESS PARK
TYNE AND WEAR
NE35 9PE

T: 0191 3822227

W: www.mm-a.net
E: info@mm-a.net

THIS DRAWING IS COPYRIGHT OF IMJAM LIMITED

NOT TO BE SCALED
ALL DIMENSIONS TO BE CHECKED ON SITE