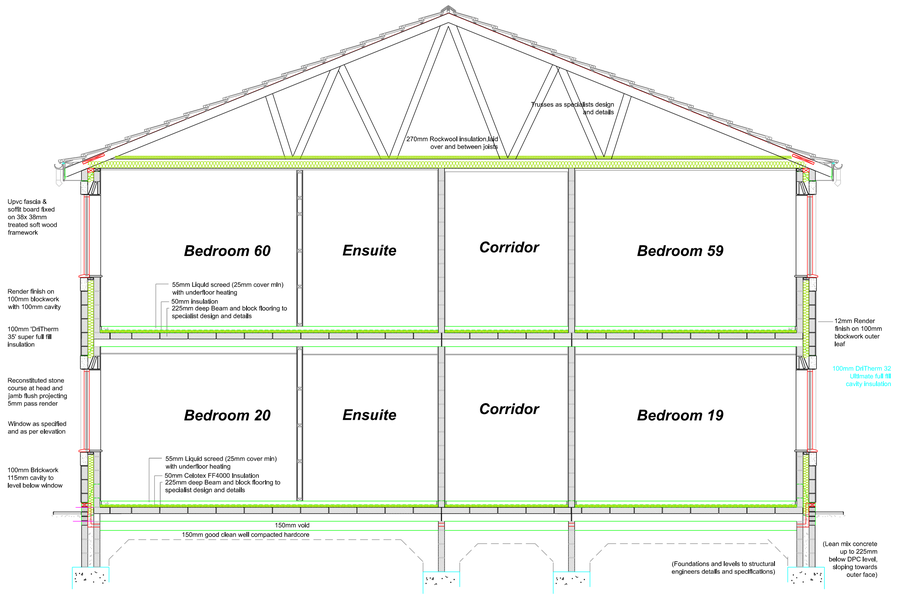

Section 'A-A'

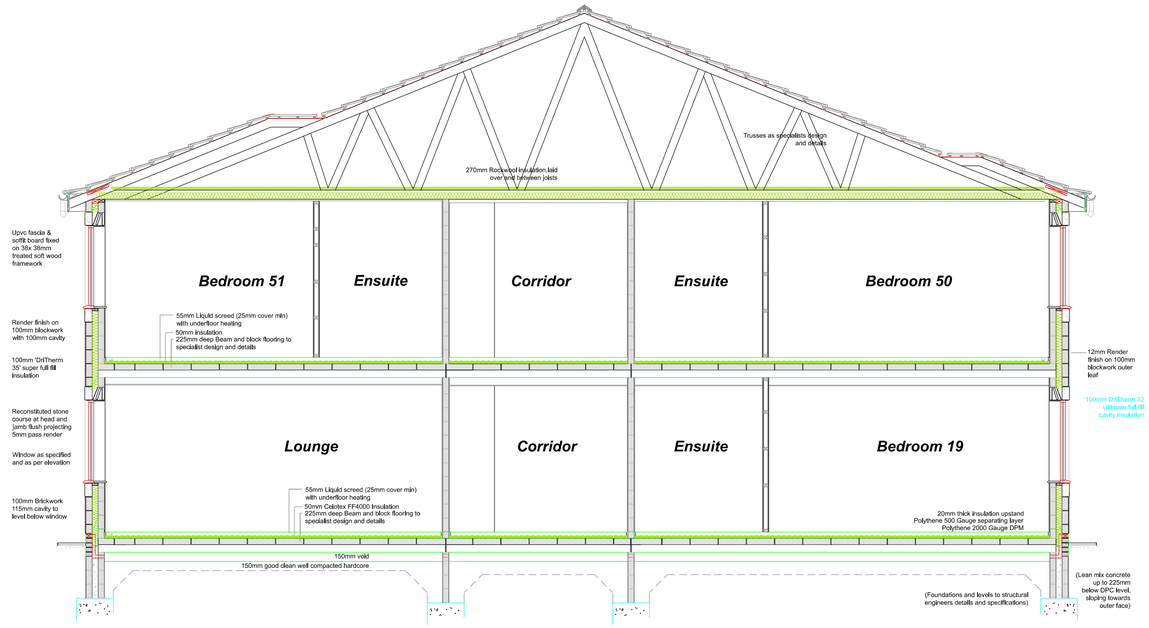

Section 'B-B'

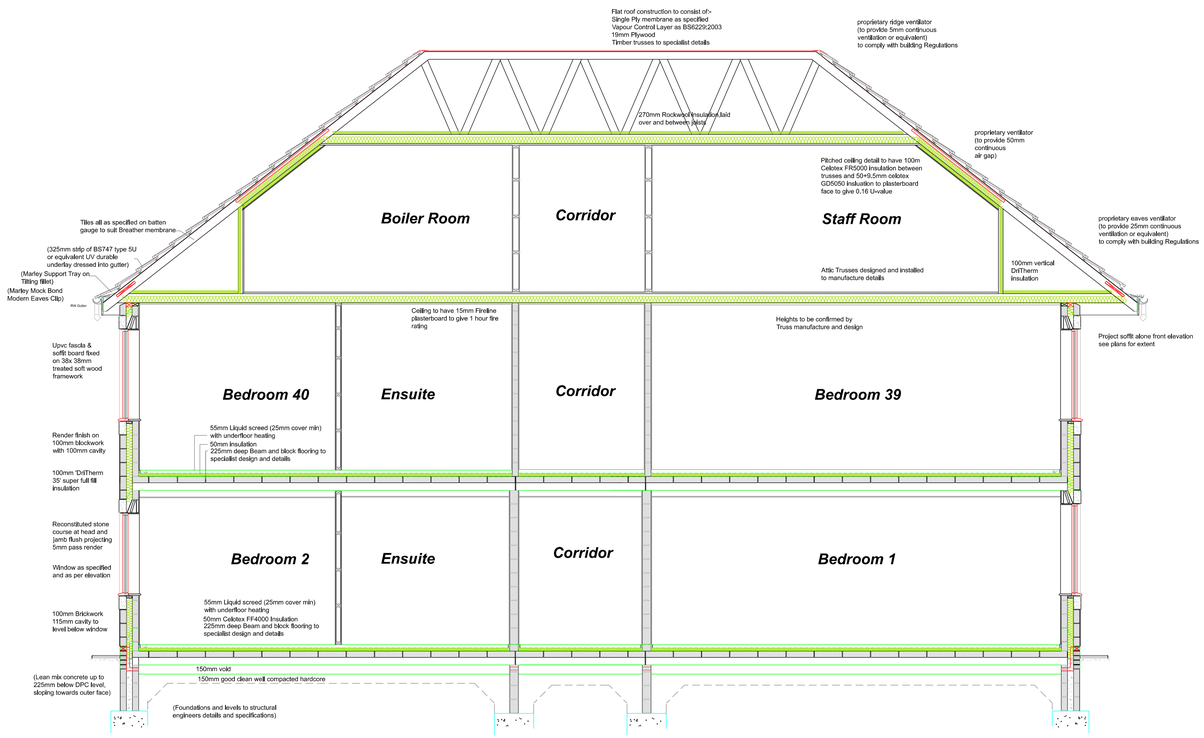

Section 'C-C'

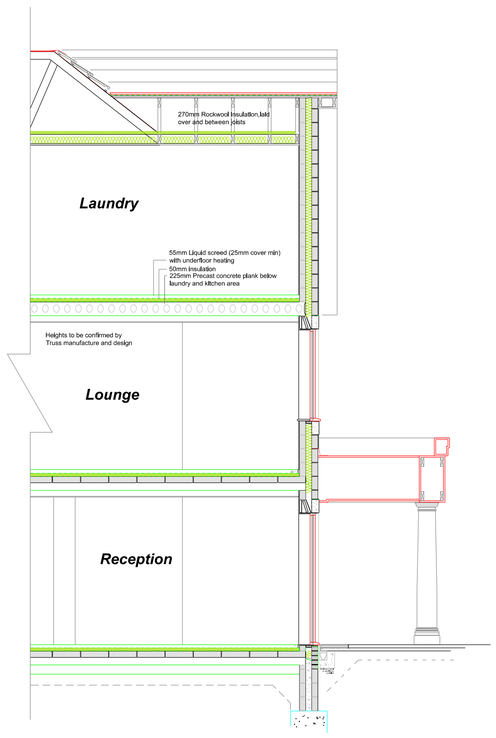

Section 'D-D'

REVISION DATE / DESCRIPTION

REVISION	NORTH

STAGE: AS BUILT

PROJECT
WALBERTON PLACE CARE HOME
YAPTON LANE
WALBERTON
ARUNDEL
WEST SUSSEX
BN18 0AS

DRAWING
SECTION DRAWINGS

PROJECT NO.	DRAWING NO.	REVISION
3112	L-04	
DATE	SCALES	DRAWN BY
APR 19	1:50@A1	

MARIO MINCHELLA ARCHITECTS

UNIT 4, WITNEY WAY,
HI-TECH VILLAGE,
BOLDON BUSINESS PARK
TYNE AND WEAR
NE35 9PE
T: 0191 3082227
W: www.mmarchs.net
E: info@mmarchs

THIS DRAWING IS COPYRIGHT OF (M)ARM LIMITED

NOT TO BE SCALED
ALL DIMENSIONS TO BE CHECKED ON SITE