

Refer to D2831 L.603

LEGEND


General Legend for all drawings



Setting Out



Refer to Fabrik drawing D2831_FAB_1_GL_DR_L_0301 for the Landscape Legend

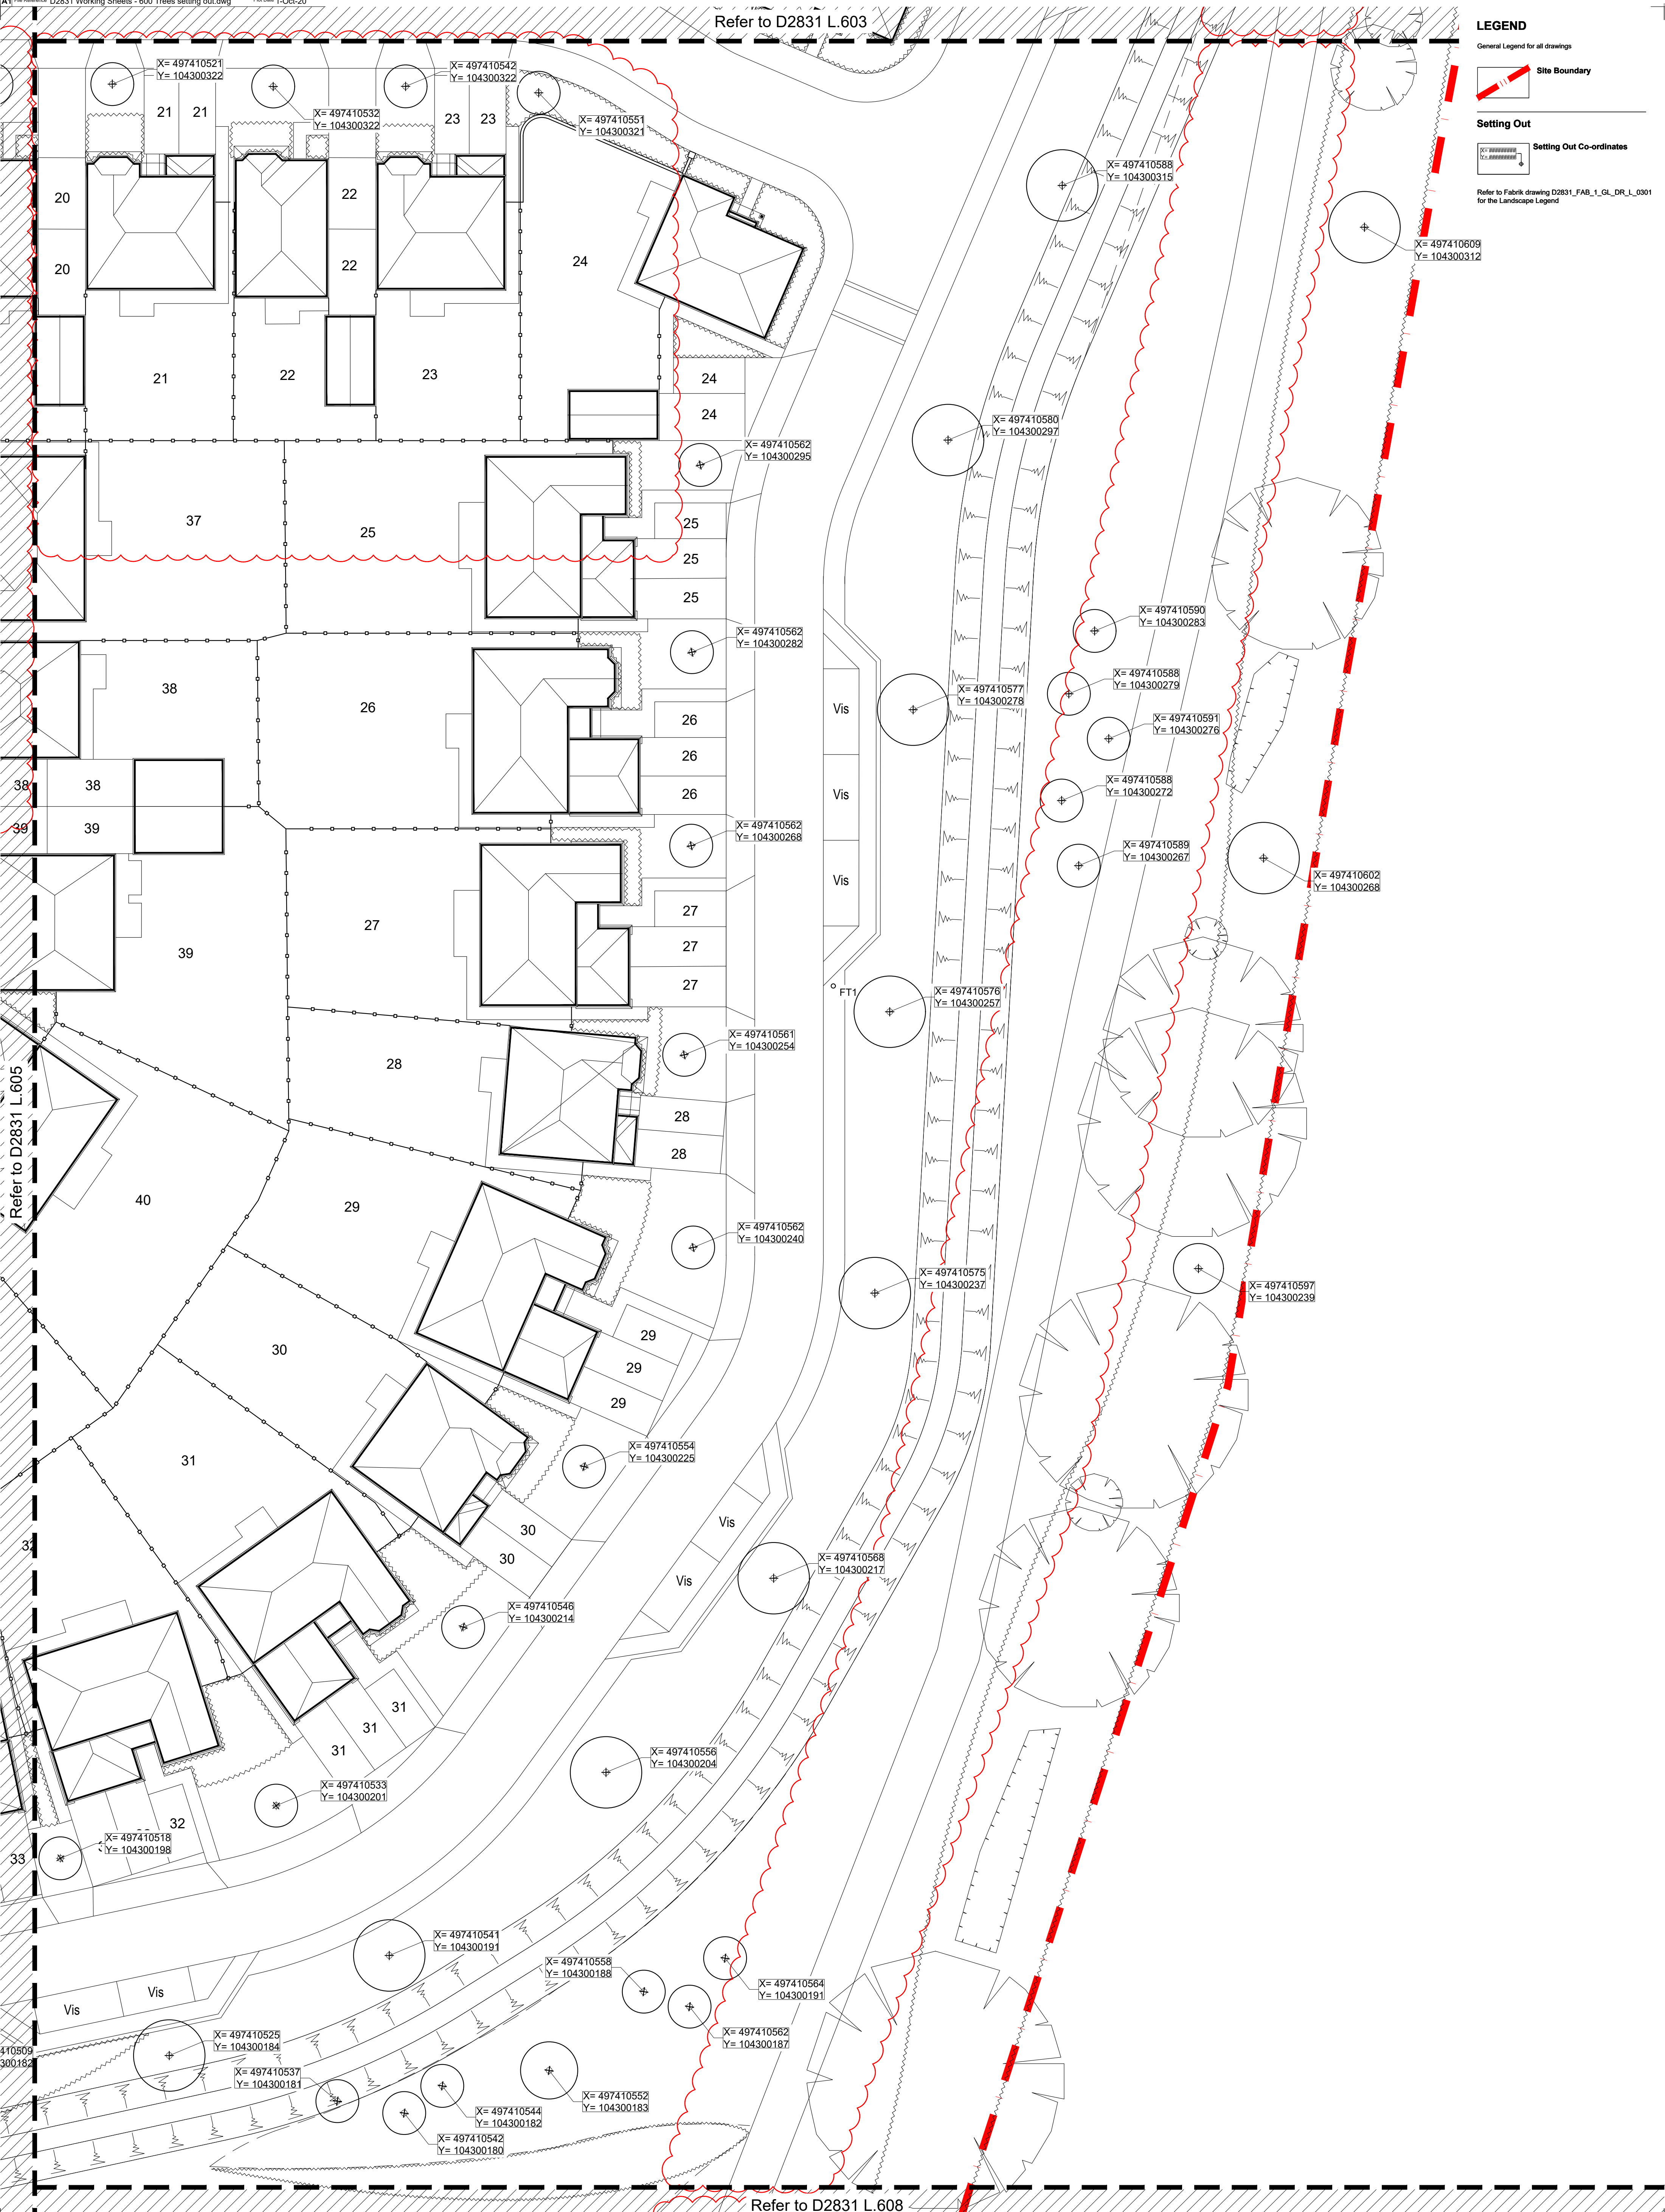

Revision

Rev	Date	Description	By	Check
PL09	02.10.2020	Amended following new Architects layout	mt	ng
PL08	14.02.2020	Amended to line with engineers drawings and client instructions	mt	ng
PL07	31.07.2020	Amended following new Architects layout	mt	ng
PL05	16.06.2020	Amended following comments received, latest drainage strategy and updated layout	mt	ng
PL04	03.06.2020	Amended following new Architects layout	mt	ng
PL03	10.01.2020	Amended following new Architects layout	pm	ng
PL02	22.11.2019	Amended following new Architects layout	pm	ng
PL01	18.11.2019	Issued for Planning	pm	ng

Disclaimers

This drawing is copyright of fabrik ltd. It must not be copied or reproduced without written consent from the owner.

2. Do not scale from this drawing. Only figured dimensions are to be taken from this drawing.

3. All contractors must read and be responsible for taking and checking all dimensions related to the works shown on the drawing prior to ARJUN 18/05/2020 10:56:53 3037270XOC

4. This drawing uses coloured lines. Please do not rely on a monochrome copy.

External References:


- D2831 Ford Lane, Yapton, West Sussex\Drawings\02 Architect\2009090_Site Layout revised\A856_65A_PLANNING LAYOUT (2) - Standard\A856_65A_PLANNING LAYOUT - Copy
- D2831 Ford Lane, Yapton, West Sussex\Drawings\07 Services\Working\AutoCAD\Design\220911_and legend
- D2831 Ford Lane, Yapton, West Sussex\Drawings\07 Services\Working\AutoCAD\Design\220911_and boundary treatment
- D2831 Ford Lane, Yapton, West Sussex\Drawings\01 Client\22-08-19 Revised Layout\Ford Lane Layout\65-65A Civil Tanks

Note for Contractors
This drawing should be considered along with the site information contained in the CDMA Pre-construction information. This information will include details of the SIGNIFICANT risks which fabrik has identified which may arise from constructing their design shown on this drawing. A Competent Contractor should be aware of the typical risks associated with doing this work.

Note for Workers
DO NOT START YOUR WORK unless you know the Risks and Controls relating to the work on this drawing (including SAFE SEQUENCES OF WORK and EQUIPMENT).

Do not issue copies of parts of this drawing without the above Note for Workers unless you are sure that the Workers can undertake the work safely.

Location Plan

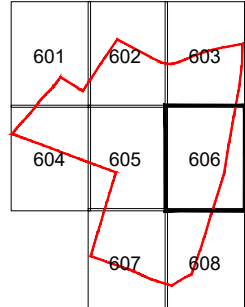

landscape architects


Project Ford Lane, Yapton, West Sussex Redrow Homes Limited

Drawing Title Boundary Treatment Plan - 6 of 8

Purpose of Issue ISSUED FOR PLANNING APPROVAL

Project Number	Origin	Zone	Level	File Type	Role	Number	Revision
D2831	FAB	00	GL	DR	L	0606	PL09