


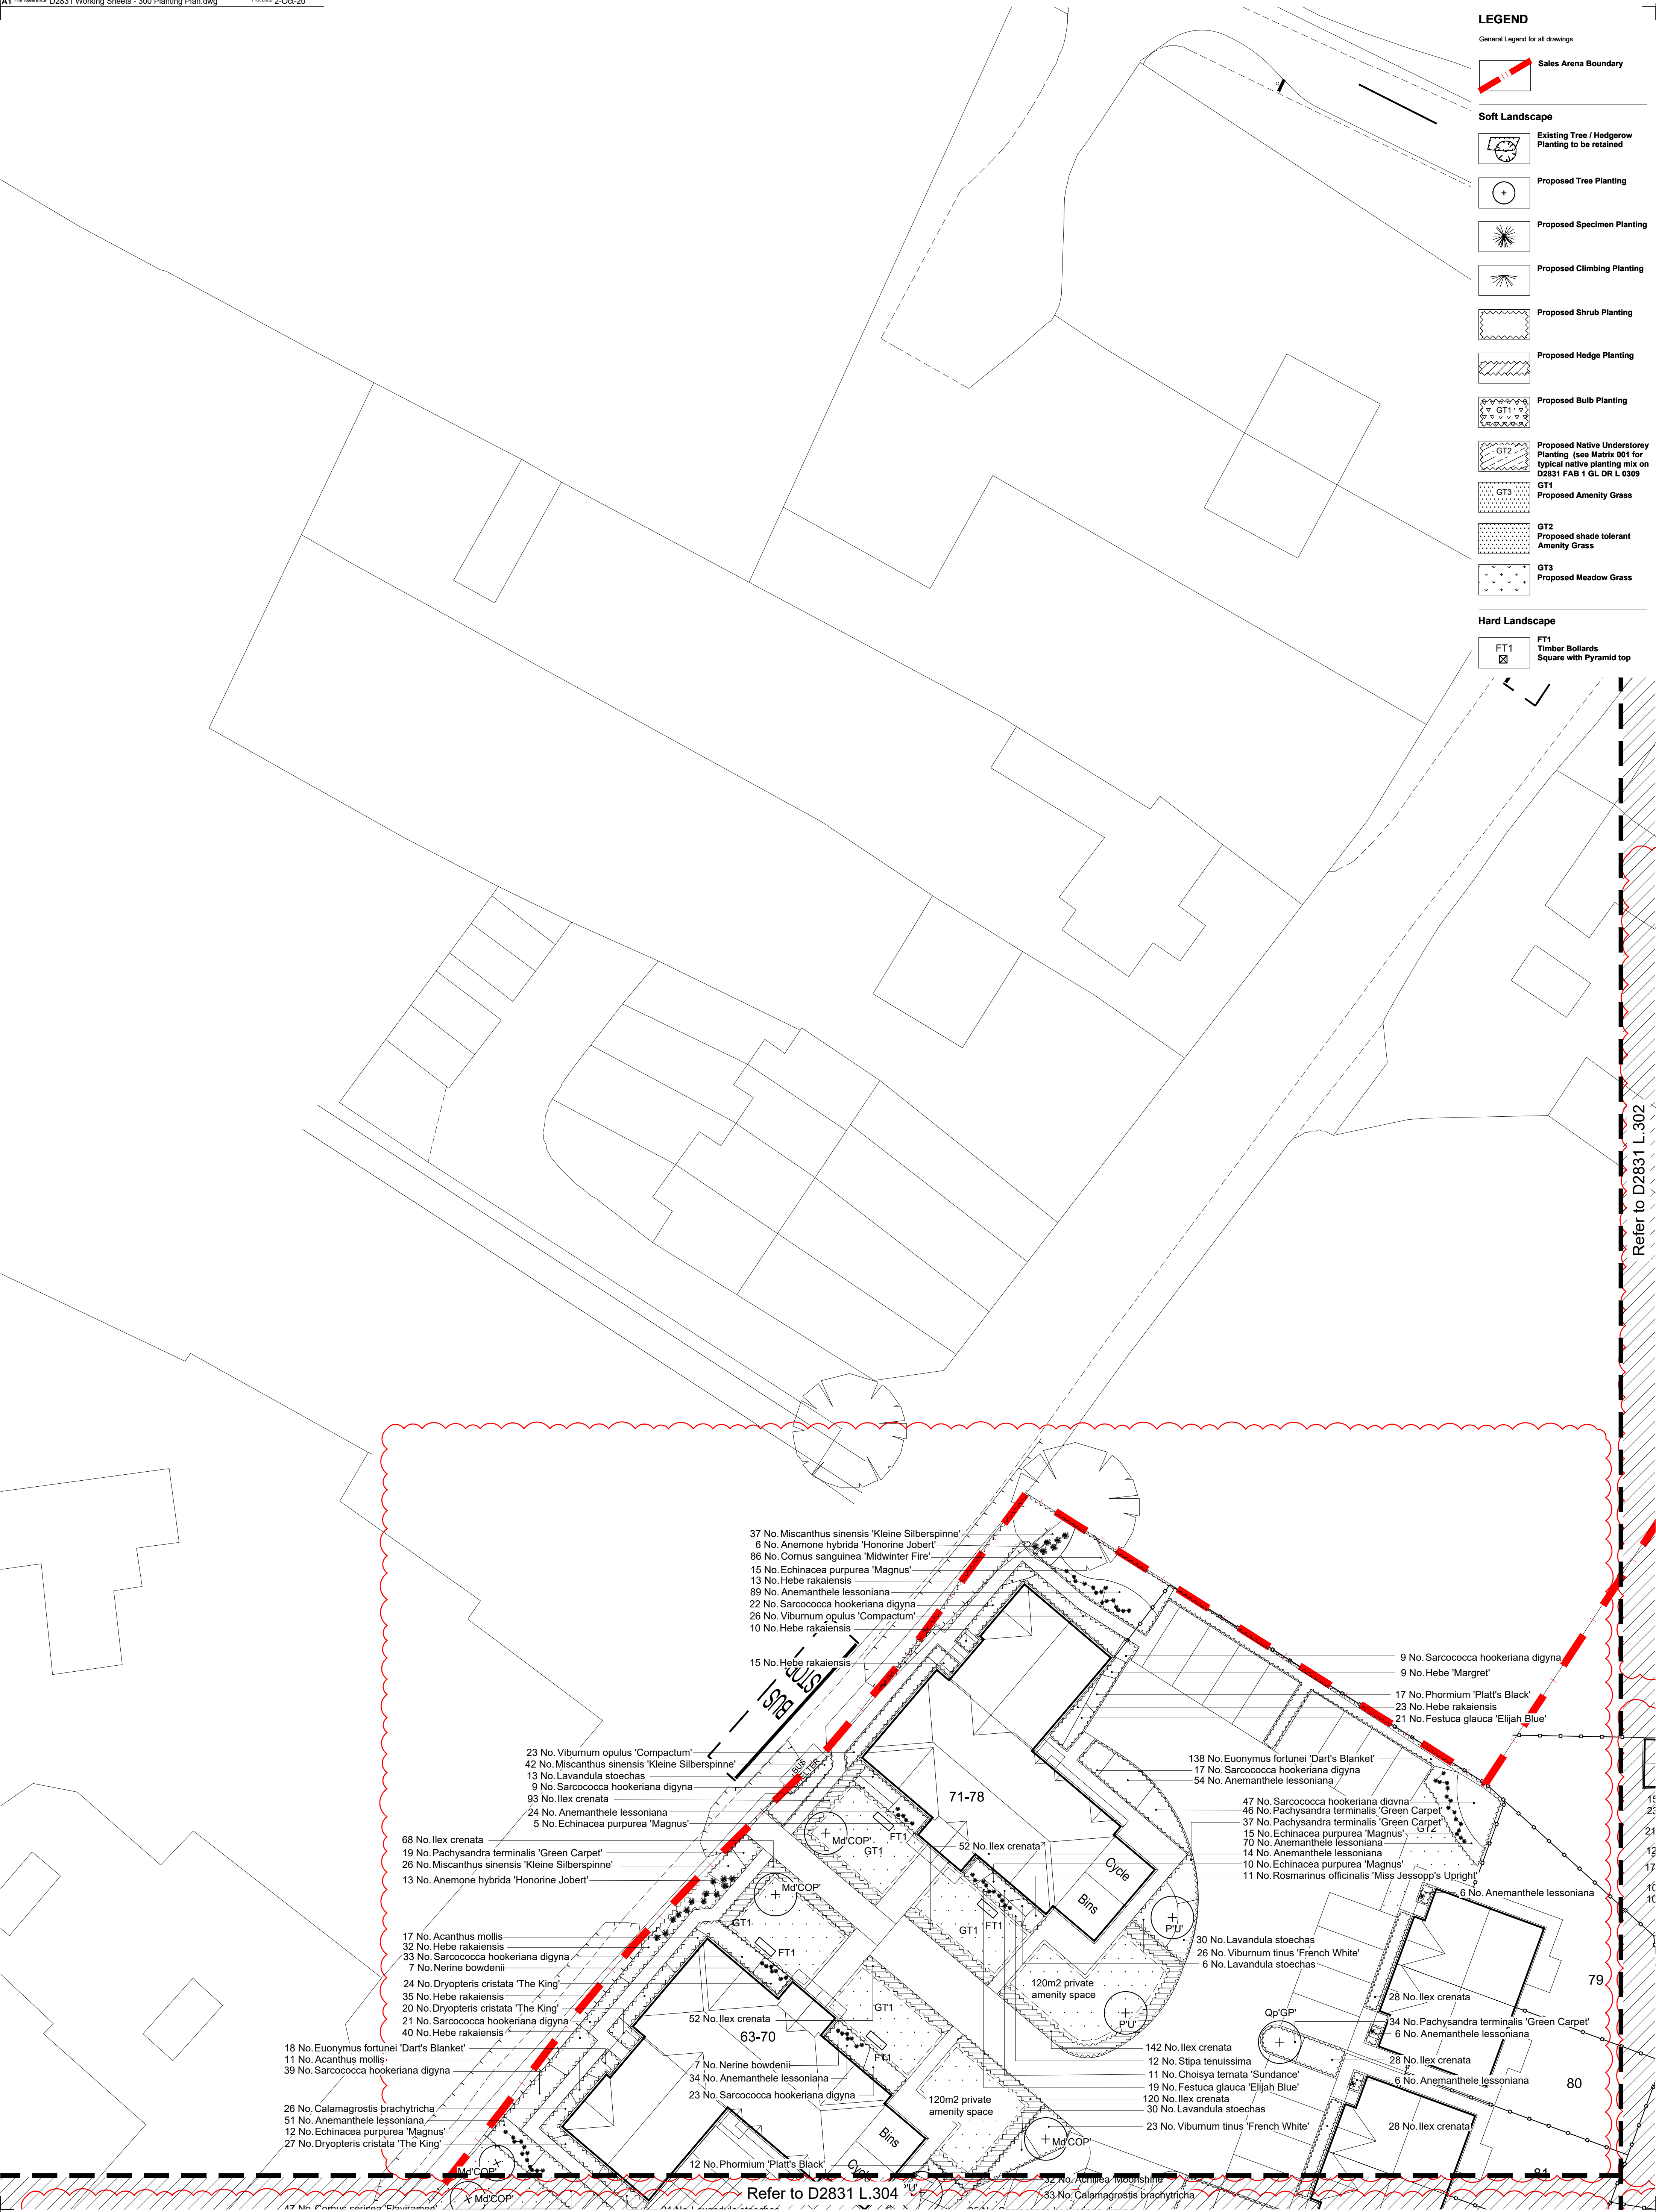

	Existing Tree / Hedgerow Planting to be retained
	Proposed Tree Planting
	Proposed Specimen Planting
	Proposed Climbing Planting
	Proposed Shrub Planting
	Proposed Hedge Planting
	Proposed Bulb Planting
	Proposed Native Understorey Planting (see Matrix 001 for typical native planting mix or D2631 FAB 1 GL DR L 0309 GT1)
	Proposed Amenity Grass
	GT2 Proposed shade tolerant Amenity Grass
	GT3 Proposed Meadow Grass

FT1 ☒	FT1 Timber Bollards Square with Pyramid top
----------	---

Refer to D2831 L.302



PL07	02.10.2020	Amended following new Architects layout	mf	sg
PL06	14.08.2020	Amended in line with engineers drawings and client instruction.	mf	sg
PL05	31.07.2020	Amended following new Architects layout	gm	sg
PL04	03.06.2020	Amended following new Architects layout	mf	wn
PL03	10.01.2020	Amended following new Architects layout	gm	sg
PL02	22.11.2019	Amended following new Architects layout	gm	sg
PL01	18.11.2019	Issued for Planning	gm	tp
Discussion			Owner	

Disclaimer:

1. This drawing is copyright of fabrik ltd. It must not be copied or reproduced without written consent from the owner.
2. Do not scale from this drawing. Only figured dimensions are to be taken from this drawing.
3. All contractors must visit site and be responsible for taking and checking all dimensions related to the works shown on the drawing prior to construction of works.
4. This drawing uses coloured lines. Please do not rely on a monochrome copy.

External References:

- D2831 Ford Lane, Vapton, West Sussex\Drawings\02 Architect\200930_Site Layout revised\A855_05A_PLANNING LAYOUT (2) - Standard\A855_05A_PLANNING LAYOUT - Copy
- D2831 Ford Lane, Vapton, West Sussex\Drawings\07 fabric\Working\AutoCAD\Design\02591_srf.dgn
- D2831 Ford Lane, Vapton, West Sussex\Drawings\07 fabric\Working\AutoCAD\Design\02591_srf.dgn
- D2831 Ford Lane, Vapton, West Sussex\Drawings\07 fabric\Working\AutoCAD\Design\02591_srf.dgn
- D2831 Ford Lane, Vapton, West Sussex\Drawings\01 Client\20-08-10 Revised Layout\Ford Lane Layout\8-344 Cellular Tanks

		landscape architects Carlen House 18, Carlen Street Abingdon Hampshire GU24 1HS T: 01420 282520 E: info@fabrikuk.com W: www.fabrikuk.com	
Project Ford Lane, Yapton, West Sussex		Client Redrow Homes Limited	
Drawing Title Detailed Planting Plan - Sheet 1 of 8			
Purpose of Issue ISSUED FOR PLANNING APPROVAL		Drawn By pmv	Checked By sg
		Drawn Scale 1:200 @ A1	Date of First Issue Nov 2019
Project Number D2831	Origin FAB	Zone 00	Level GL
File Type DR	Role L	Number 0301	Revision PL07