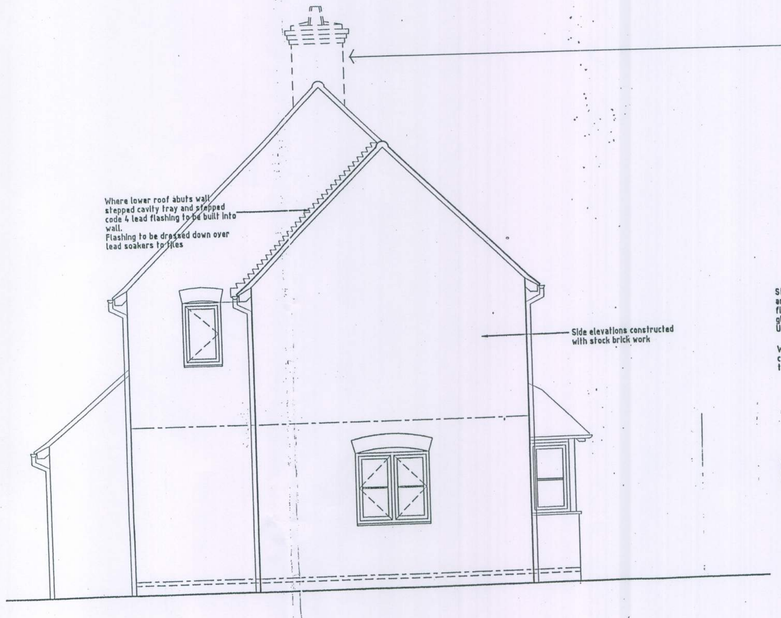

North West Elevation

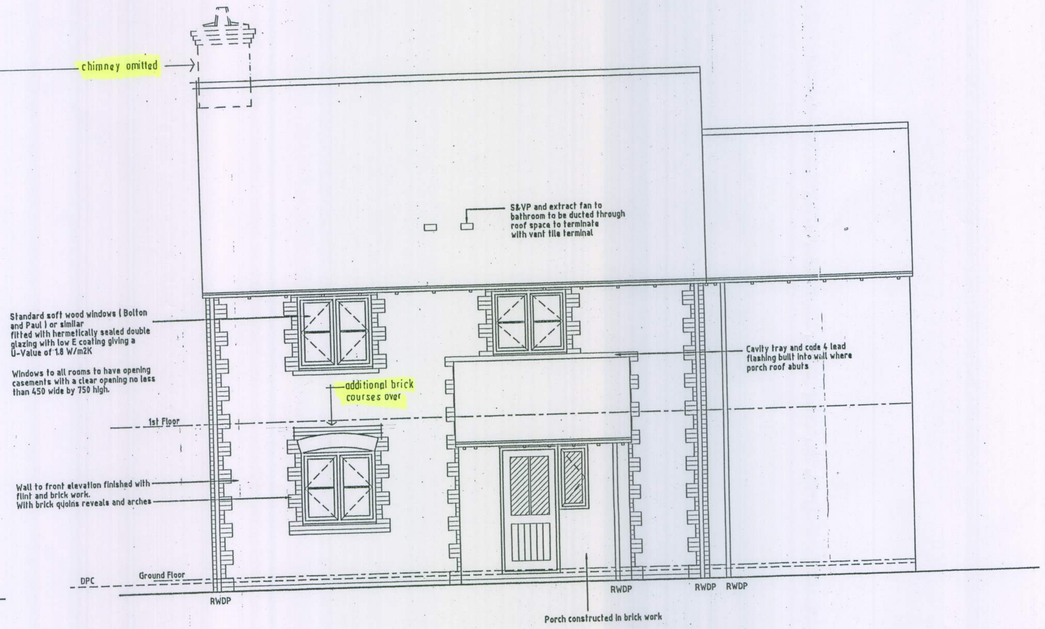

North East Elevation

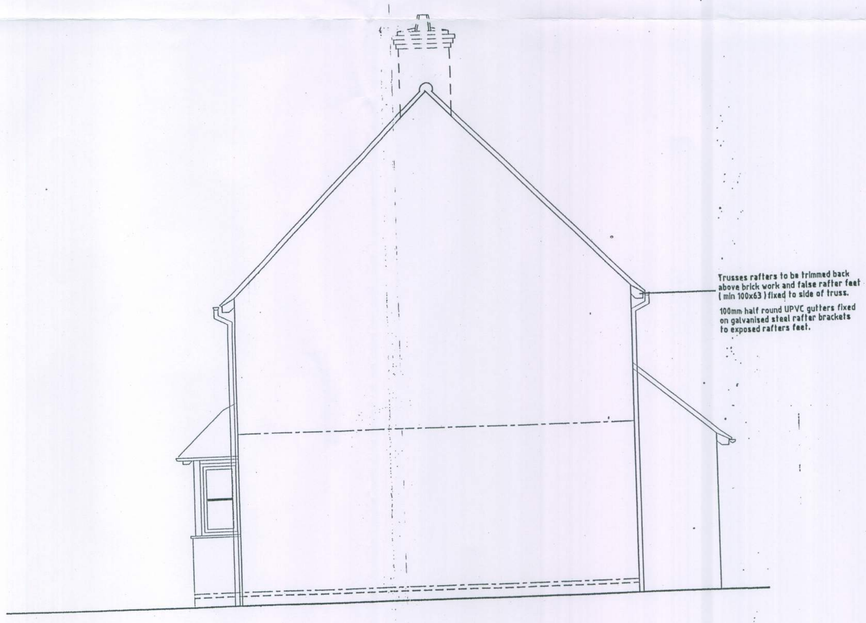

South East Elevation

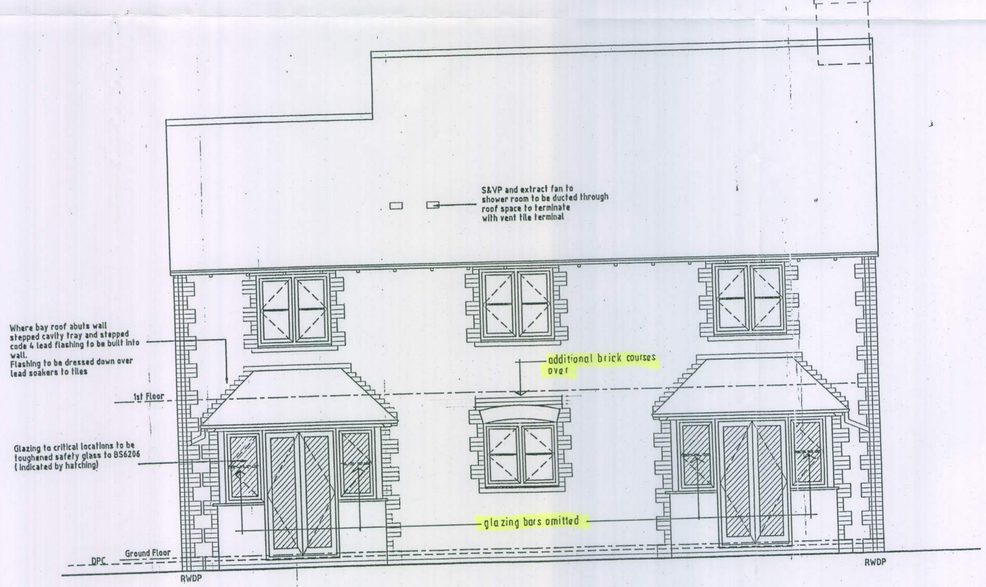

South West Elevation

ARUN DISTRICT COUNCIL
No. 7 55 08 BR
Dated 09 JUN 2008

REVISION B. SEPT: 2011 AS BUILT & SHOWING NON-MATERIAL AMENDMENTS.

Rev A Additional window added on North West Elevation

May 2008

REVISION

R J C A
CHARTERED ARCHITECTS

LIME KILN BARN
COLWORTH
CHICHESTER
WEST SUSSEX
PO20 6DS

Tel 01243 787011
Fax 01243 787022

PROJECT: Proposed development at Victoria House, Yapton			
SUBJECT: Plot 1 - Elevations			
SCALE 1:50	DATE Mar 08	DRAWING No 05 / 51 / 103	Rev ~~A~~ B
DRAWN	CHECKED		

ARUN DISTRICT COUNCIL Y/47/11/NMA