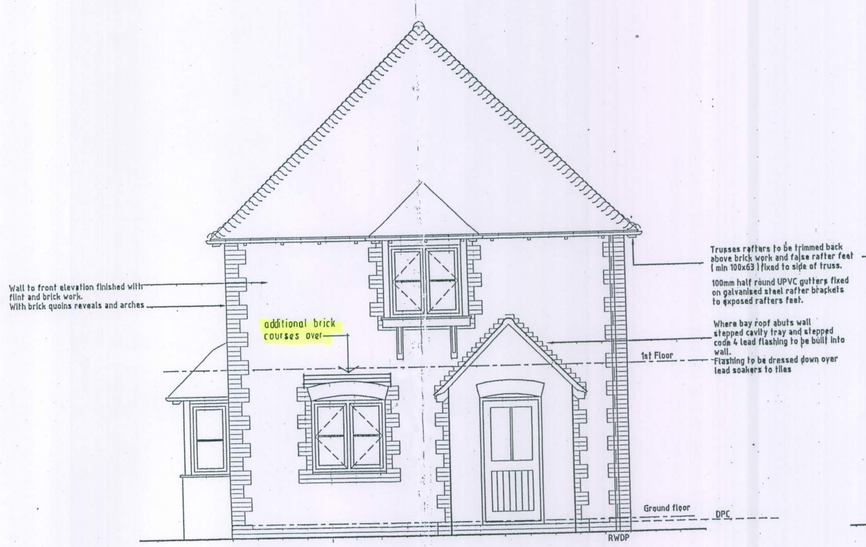

North East Elevation

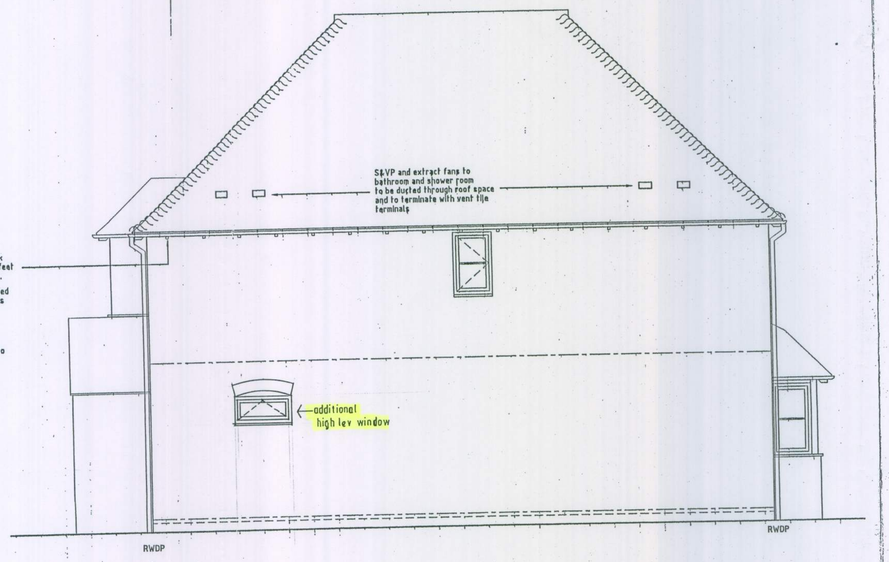

North West Elevation

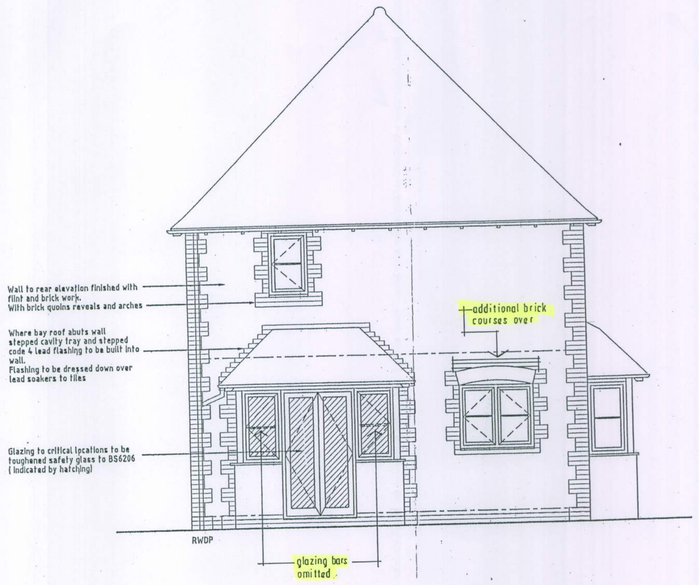

South West Elevation

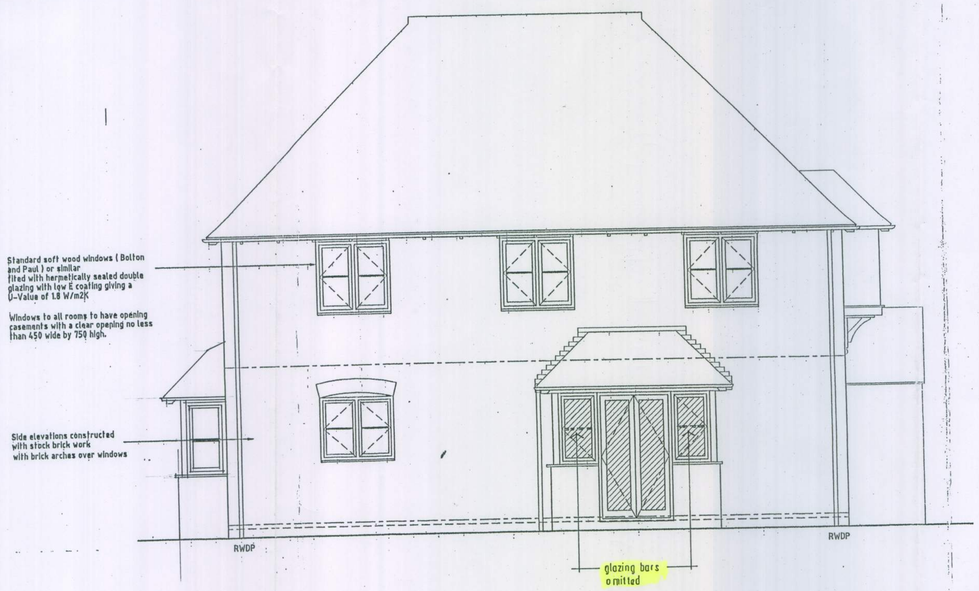

South East Elevation

R J C A
CHARTERED ARCHITECTS

LIME KILN BARN
COLWORTH
CHICHESTER
WEST SUSSEX
PO20 6DS

Tel 01243 787011
Fax 01243 787022

REVISION A.SEPT: 2011 AS BUILT & SHOWING NON:MATERIAL AMENDMENTS

REVISION

PROJECT	Proposed development at Victoria House, Yapton		
SUBJECT	Plot 2 - Elevations		
SCALE 1:50	DATE Mar 08	DRAWING No 05 / 51 / 107	REV A
DRAWN	CHECKED		

ARUN DISTRICT COUNCIL Y/47/11/NMA