


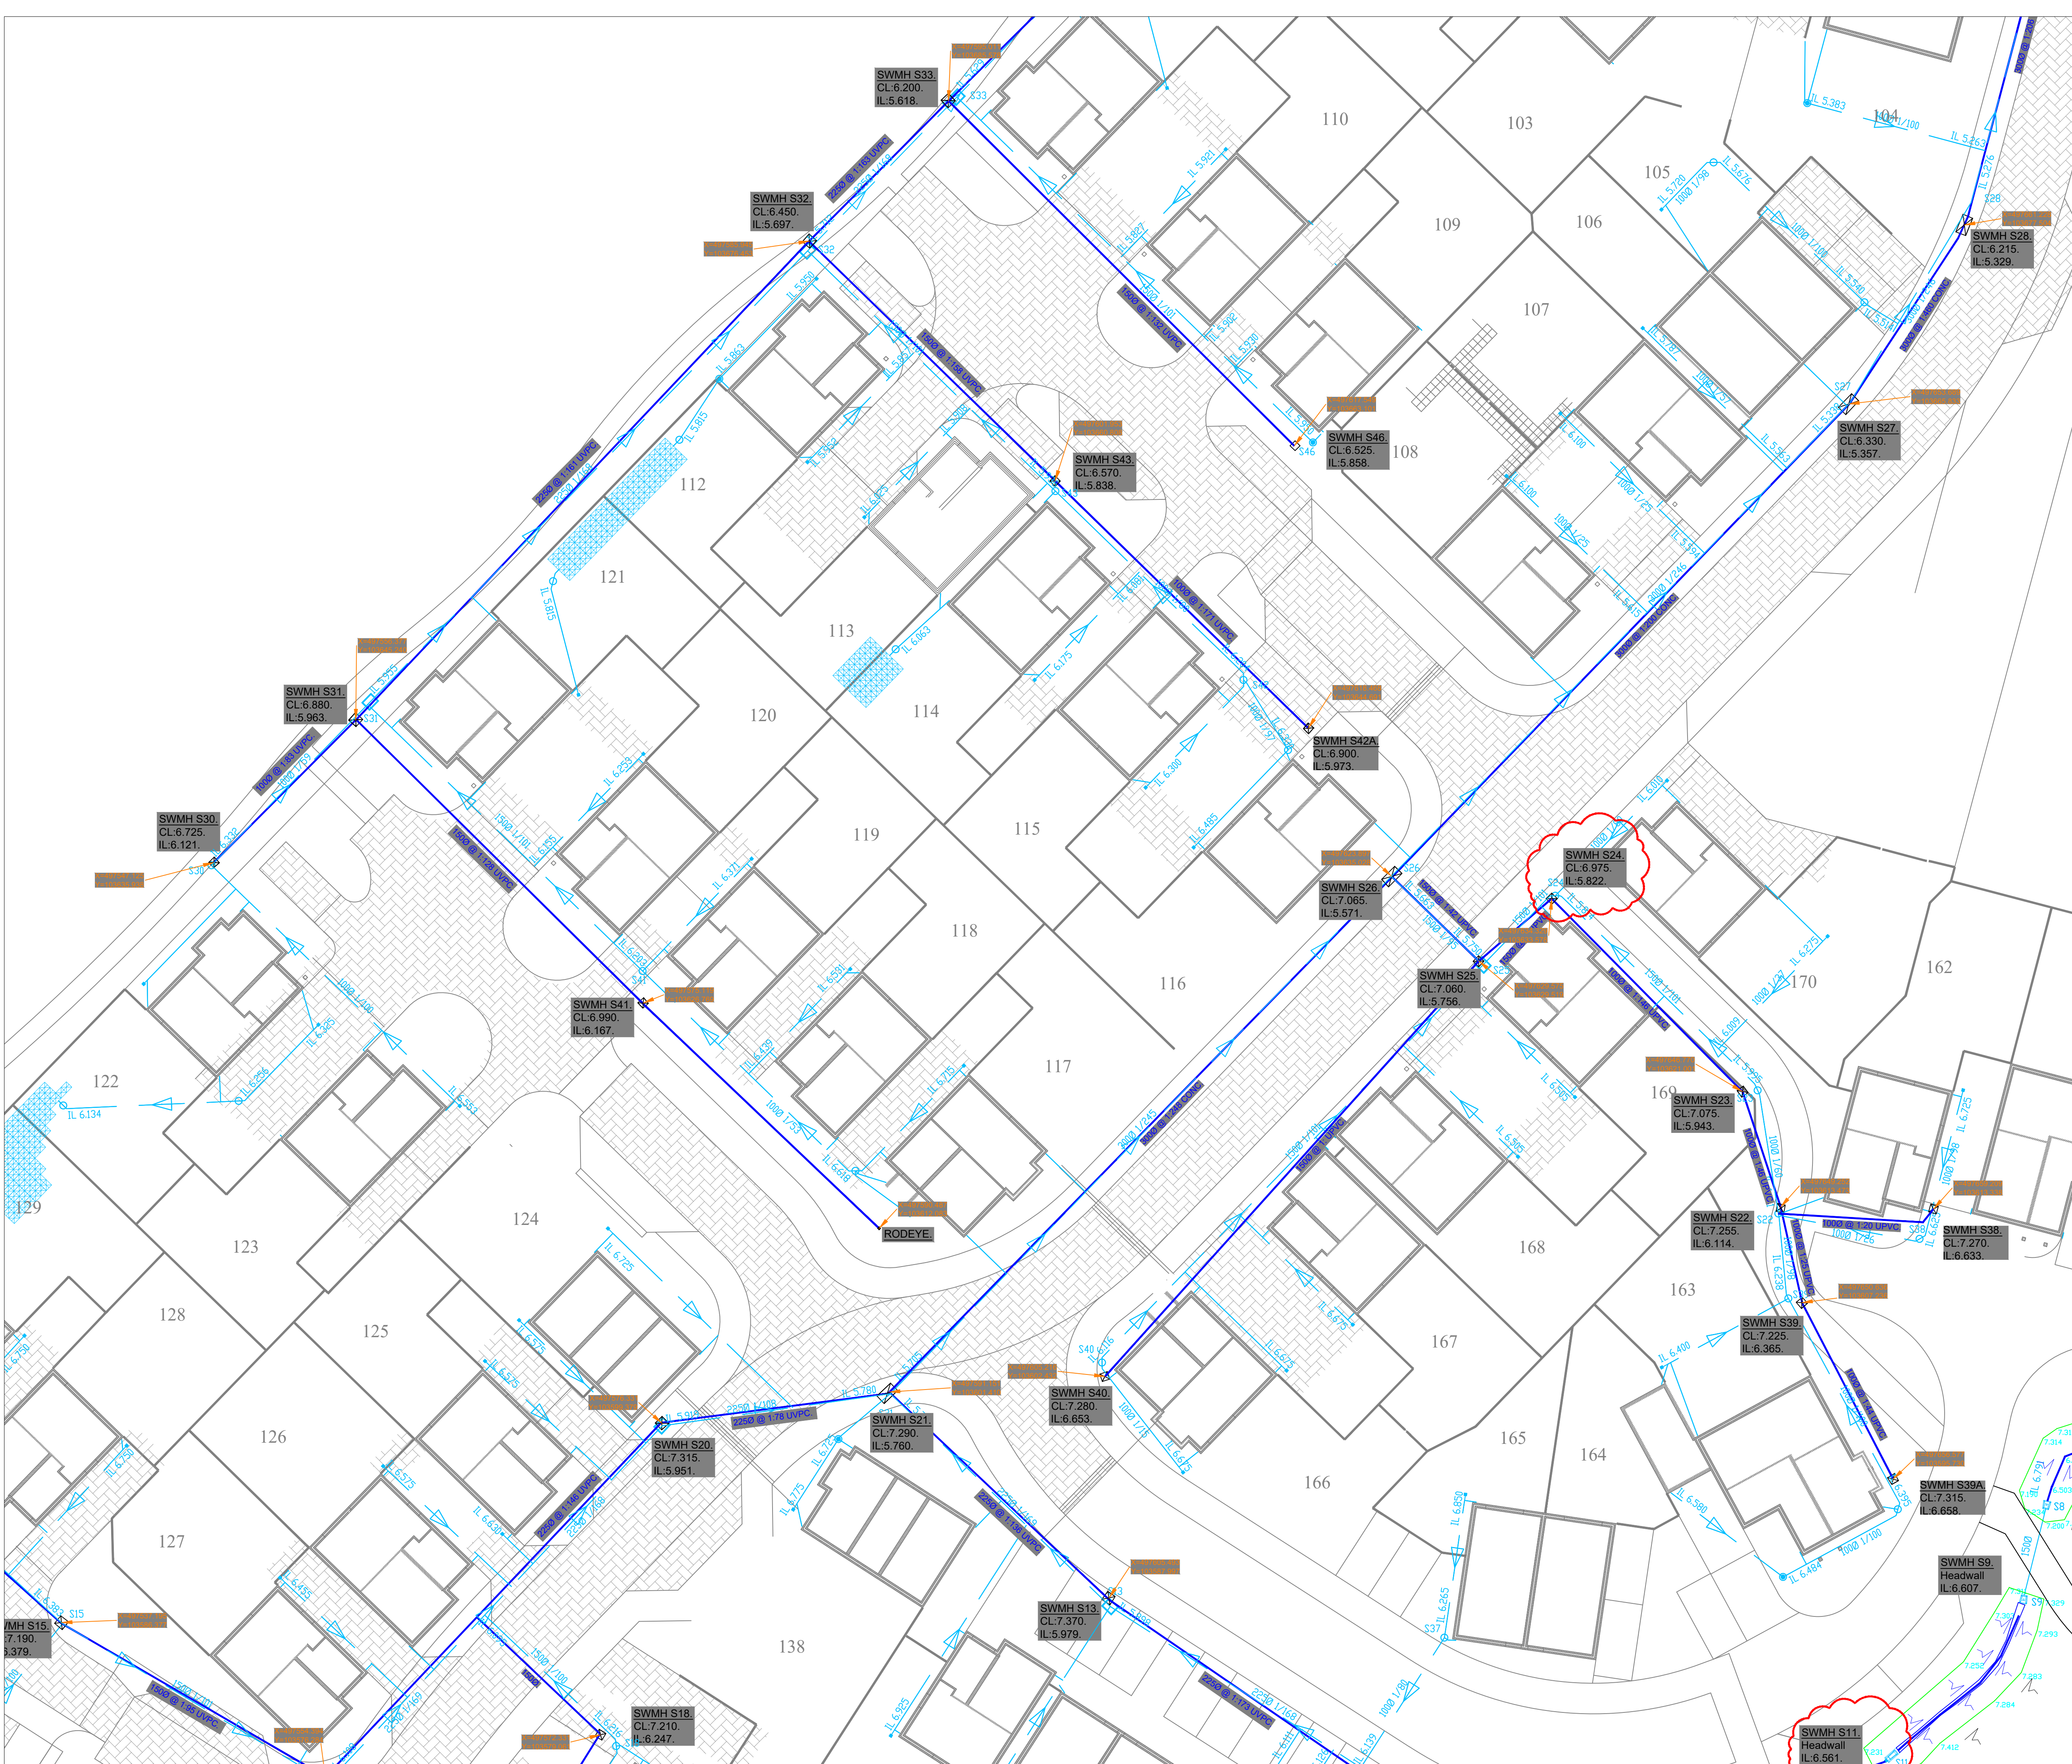

NOTES:

This Drawing is for As Built / Technical Query reasons only and not to be used for setting out unless drawing is approved and signed off and copies emailed to NRS Surveying Ltd.

No Original Control or Topographical Stations located on site. No Control issued by Parchow Groundworks prior to survey.

New control points installed using GPS and relate to OSGB36(15). 200 RTK positions taken on each ground control point;

Survey completed using EDM. The grid is related to OS using Industry Standard Network RTK GPS. All levels are related to OS Grid using Industry Standard Network RTK GPS.

STN GPS Nail 01: 497727.471E, 103792.136N, 6.890Z.
STN GPS Nail 02: 497783.571E, 103771.831N, 7.676Z.

From this Set Up New Control Stations Installed.

Drawing completed on behalf of Dandara.

Survey completed: 28/06/2023, 29/06/2023, 18/10/2024, 24/10/2025 - N.Rogers - NRS Surveying Ltd.

Rev B Drawing Issued 24/03/2025 - Remaining Section Phase II Now Complete Including Remedial Works - N.Rogers - NRS Surveying Ltd.



NRS Surveying Limited,
6 Purbrook Way,
Havant,
Hampshire
PO9 3RY
Mobile:
07564 602518.
Email:
nrsurveying@gmail.com

Client: dandara

Project: Paddock View,
Yapton, West Sussex.

Drawing Title: As Built
Storm Drainage Survey
Phase 2 as Marked by
David Linton-Clowes -
Dandara Sheet 2.

Scale @ A1: xxxxx	Drawn Date: 07/07/2023.	Project Number: Dandara -Paddock View-003 Rev B.
Drawn By: Nick Rogers.	Checked By: Nick Rogers & SS.	