


LEGEND

General Legend for all drawings

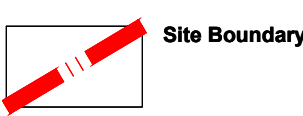


Setting Out



Refer to Fabrik drawing D2831_FAB_1_GL_DR_L_0301 for the Landscape Legend

Refer to D2831 L.602

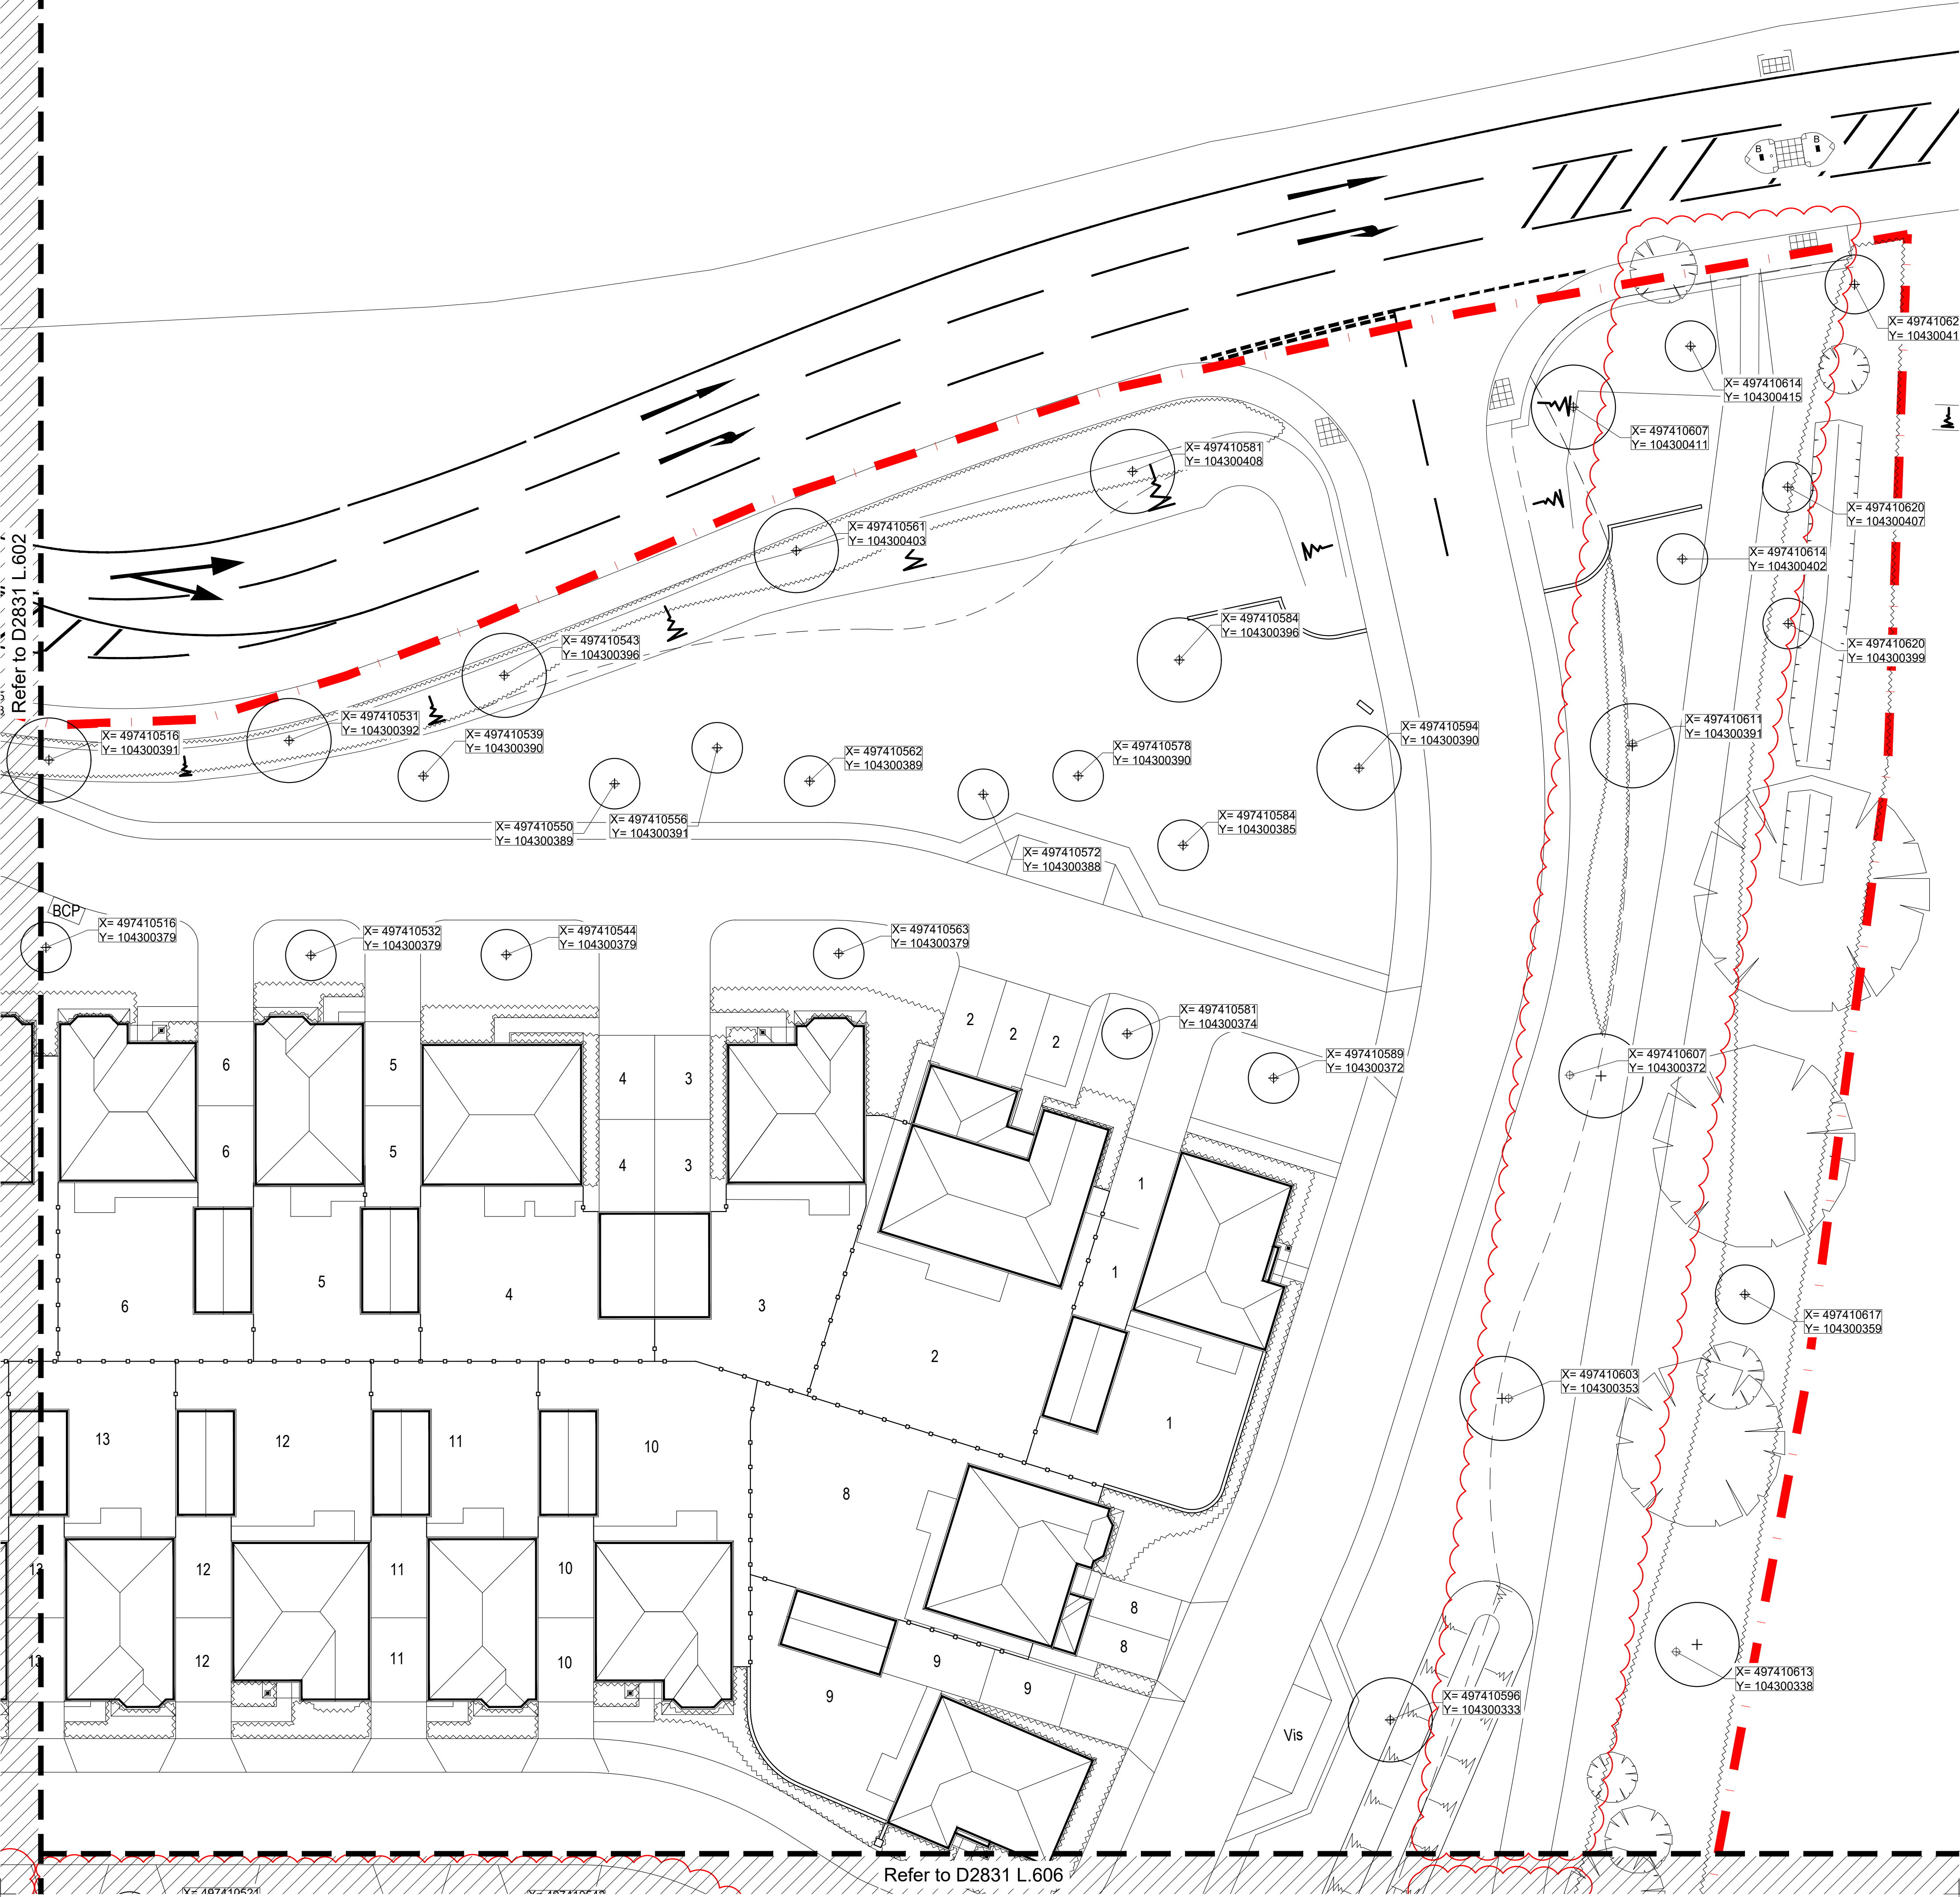

Revision	Date	Drawn	Checked
PL09	02.10.2020	amf	ng
PL08	14.08.2020	amf	ng
PL07	31.07.2020	amf	wh
PL05	16.06.2020	amf	ng
PL04	03.06.2020	amf	am
PL03	10.01.2020	pm	ng
PL02	22.11.2019	pm	ng
PL01	18.11.2019	pm	ng

Disclaimers:

- This drawing is copyright of fabrik ltd. It must not be copied or reproduced without written consent from the owner.
- Do not scale from this drawing. Only figured dimensions are to be taken from this drawing.
- All contractors must read and be responsible for taking and checking all dimensions related to the works shown on the drawing prior to ARJUN 18/11/2019 15:00:00
- This drawing uses coloured lines. Please do not rely on a monochrome copy.


External References:

- D2831 Ford Lane, Yapton, West Sussex\Drawings\02 Architecture\2009\00_Site Layout revised\A855_BSA_PLANNING LAYOUT (2) - Standard\A855_BSA_PLANNING LAYOUT - Copy
- D2831 Ford Lane, Yapton, West Sussex\Drawings\07 Services\Working\AutoCAD\Design\22091_ and legend
- D2831 Ford Lane, Yapton, West Sussex\Drawings\07 Services\Working\AutoCAD\Design\22091_ and boundary treatment
- D2831 Ford Lane, Yapton, West Sussex\Drawings\01 Client\02-08-10 Revised Layout\Ford Lane Layout\BSA Cellular Tanks

Note for Contractors
This drawing should be considered along with the risk information contained in the CDMA Pre-construction Information. This information will include details of the SIGNIFICANT risks which fabrik has identified which may arise from constructing their design shown on this drawing. A Competent Contractor should be aware of the typical risks associated with doing this work.

Note for Workers
DO NOT START YOUR WORK unless you know the Risks and Controls relating to the work on this drawing (including SAFE SEQUENCES OF WORK and EQUIPMENT).

Do not issue copies of parts of this drawing without the above Note for Workers unless you are sure that the Workers can undertake the work safely.

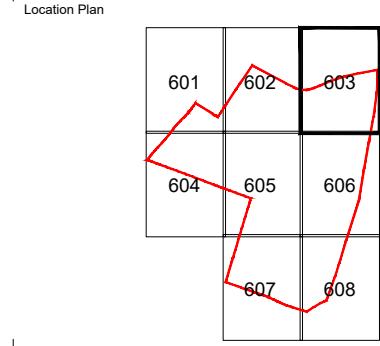



landscape architects

Lennox House | 15 Lennox Street | Alton | Hampshire | GU24 1HG
T: 01429 593250 | E: alton@fabrik.co.uk | W: www.fabrik.co.uk

Project: Ford Lane, Yapton, West Sussex

Drawing Title: Tree Setting Out Plan - 3 of 8

Proposed Issue: ISSUED FOR PLANNING APPROVAL

Client: Redrow Homes Limited

Drawn By: pm	Checked By: sg	Drawn Scale: 1:200 @ A1	Date of First Issue: Nov 2019
--------------	----------------	-------------------------	---------------------------------

Project Number	Client	Zone	Level	File Type	Role	Number	Revision
D2831	FAB	00	GL	DR	L	0603	PL09